

1
2
ADDENDUM NO. 2

ISSUE DATE: September 19, 2023

RE: CHEMISTRY 2nd and 4th FLOOR LAB RENOVATION
UNIVERSITY OF WISCONSIN - MADISON
MADISON, WISCONSIN

UW-Madison Project No. **0047 2301** /UWSA Project No. **A-22-015**

BID SUBMISSION DUE by 1:30 PM, September 28, 2023

BID SUBMISSION DUE by 1:30 PM, October 12, 2023

FROM: Strang, Inc.
811 East Washington Avenue, Suite 200
Madison, WI 53703

TO: Prospective Bidders

This addendum forms a part of the Contract Documents and modifies the original Contract Documents dated September 19, 2023, as noted below. Acknowledge receipt of this Addendum by inserting the number and issue date of this addendum in the blank space provided on the Bid Form. Failure to do so may subject the Bidder to disqualification.

This Addendum consists of 3 pages and the attached documents:

DRAWINGS

- T001 – TITLE SHEET
- S104.1 – PLAN – 4TH FLOOR
- AD102.3-d – DEMOLITION PLAN – 2ND FLOOR – DANIELS (NORTH)
- A038 – DOOR SCHEDULE, TYPES, & DETAILS
- A304 – REFLECTED CEILING PLAN – 4TH FLOOR
- A715 – INTERIOR ELEVATIONS
- E102-5-d - ELECTRICAL POWER PLAN - 2ND FLOOR DANIELS (NORTH)
- E104-1 - ELECTRICAL POWER PLAN 4TH (WEST)
- E104-2 - ELECTRICAL POWER PLAN 4TH (EAST)
- E204 - ELECTRICAL LIGHTING PLAN - 4TH FLOOR.
- E904 - LIGHTING SCHEDULE
- E920 - ELECTRICAL PANEL SCHEDULE
- E921 - ELECTRICAL PANEL SCHEDULE
- E922 - ELECTRICAL PANEL SCHEDULE
- E923-d - ELECTRICAL PANEL SCHEDULE - DANIELS

CHANGES TO BIDDING REQUIREMENTS:

1. None

CHANGES TO CONDITIONS OF THE CONTRACT:

2. None

1
2 **CHANGES TO SPECIFICATIONS (DIVISIONS 2 THRU 33):**
3

- 4 3. Table of Contents
5 a. Removed Section 08 41 13 Aluminum-Framed Entrances and Storefront from the Project.
6
7 4. Section 08 44 35 Protective Framed Glazing Assemblies
8 a. Added a manufacturer.
9
10 5. Section 09 67 23 Resinous Flooring
11 a. Revised floor system descriptions.
12
13

14 **CHANGES TO DRAWINGS:**
15
16

- 17 1. DRAWING SHEET T001 – Replace sheet with revised sheet attached to the addendum.
18 a. Added information to identify the number of stories existing building consists of.
19
20 2. DRAWING SHEET S104.1 – Replace sheet with revised sheet attached to the addendum.
21 a. Removed details and elevations reference marks.
22
23 3. DRAWING SHEET AD102.3-d – Replace sheet with revised sheet attached to the addendum.
24 a. Removed keyed notes D05.7, D05-8 and D03.25.
25 b. Revised keyed note D08.4.
26
27 4. DRAWING SHEET A038 – Replace sheet with revised sheet attached to this addendum.
28 a. 45 Minute fire rating designation added to door schedule at doors 4429A and 4429B.
29 b. Drawing reference added to 5/A038 for clarification.
30
31 5. DRAWING SHEET A304: Replace sheet with revised sheet attached to this addendum.
32 c. Dimensional clarification of pendant light location in corridor 4400M
33
34 6. DRAWING SHEET A715: Replace sheet with revised sheet attached to this addendum.
35 d. Detail 7: Dimensional clarification of device locations on west wall of Room 4421.
36 e. Detail 8: Drawing reference added for clarification.
37
38 7. DRAWING SHEET E102.5-d – Replace Sheet with revised Sheet attached to this addendum.
39 a. Revised circuiting so numbers are numerically in order and organized.
40
41 8. DRAWING SHEET E104.1 – Replace Sheet with revised Sheet attached to this addendum.
42 a. Revised circuiting so numbers are numerically in order and organized.
43
44 9. DRAWING SHEET E104.2 – Replace Sheet with revised Sheet attached to this addendum.
45 a. Revised circuiting so numbers are numerically in order and organized.
46
47 10. DRAWING SHEET E204 – Replace Sheet with revised Sheet attached to this addendum.
48 a. Conference Room 4421: Relocate type L32 luminaires to match Architectural RCP.
49 b. Conference Room 4444: Relocate type L3 luminaires to match Architectural RCP
50
51 11. DRAWING SHEET E904 – Replace Sheet with revised Sheet attached to this addendum.
52 a. Revise luminaire type L1, L3, L9, L12B, L12D and L31 to remove Axis lighting.
53 b. Type L32 Add Aculux.
54
55 12. DRAWING SHEET E920 – Replace Sheet with revised Sheet attached to this addendum.
56 a. Revised circuiting information in panelboards.
57
58 13. DRAWING SHEET E921 – Replace Sheet with revised Sheet attached to this addendum.
59 a. Revised circuiting information in panelboards.
60

1	TABLE OF CONTENTS TECHNICAL SPECIFICATIONS <small>(02/2017)</small>		
2	UW-Madison Project No. 0084 2014 /UWSA Project No. A-22-015		
3			
4	VOLUME 2		
5			Pages Thru
6	TITLE PAGE		1
7	TABLE OF CONTENTS		TC-8
8			
9	DIVISION 02 – EXISTING CONDITIONS		
10	Section	Title	Pages Thru
11	02 05 00	Common Work Results for Existing Conditions	02 05 00-03
12	02 41 13	Demolition	02 41 13-04
13			
14	DIVISION 03 – CONCRETE		
15	Section	Title	Pages Thru
16	03 05 00	Concrete Repair	03 05 00-01
17	03 30 00	Cast-In-Place Concrete	03 30 00-20
18			
19	DIVISION 04 – MASONRY		
20	Section	Title	Pages Thru
21	04 20 00	Unit Masonry	04 20 00-9
22			
23	DIVISION 05 – METALS		
24	Section	Title	Pages Thru
25	05 12 00	Structural Steel Framing	05 12 00-08
26	05 31 13	Steel Floor Decking	05 31 13-04
27	05 50 00	Metal Fabrications	05 50 00-03
28	05 52 13	Pipe and Tube Railings	05 52 13-06
29	05 70 00	Decorative Metal	05 70 00-05
30			
31	DIVISION 06 – WOOD, PLASTICS AND COMPOSITES		
32	Section	Title	Pages Thru
33	06 10 53	Miscellaneous Rough Carpentry	06 10 53-02
34	06 41 16	Plastic-Laminate-Faced Architectural Woodwork	06 40 23-03
35			
36	DIVISION 07 - THERMAL AND MOISTURE PROTECTION		
37	Section	Title	Pages Thru
38	07 81 00	Applied Firestopping	07 81 00-05
39	07 84 00	Fire Stopping	07 84 00-09
40	07 92 00	Joint Sealants	07 92 00-06
41	07 95 13.13	Interior Expansion Join Cover Assemblies	07 95 13.13-05
42			
43	DIVISION 08 - OPENINGS		
44	Section	Title	Pages Thru
45	08 11 13	Hollow Metal Doors and Frames	08 11 13-07
46	08 14 16	Flush Wood Doors	08 14 16-03
47	08 31 13	Access Doors and Frames	08 31 13-02
48	08 41 13	Aluminum Framed Entrances and Storefronts	08 41 13-06
49	08 44 35	Protective Framed Glazing Assemblies	08 44 35-02
50	08 71 00	Finish Hardware	08 71 00-21
51	08 80 00	Glazing	08 80 00-05
52			
53	DIVISION 09 - FINISHES		
54	Section	Title	Pages Thru

1	09 22 16	Non-Structural Metal Framing	09 22 16-05
2	09 27 00	Plaster Fabrications	09 27 00-02
3	09 29 00	Gypsum Board	09 29 00-07
4	09 30 13	Ceramic Tiling	09 30 13-04
5	09 51 23	Acoustical Panel Ceilings	09 51 23-02
6	09 54 26	Suspended Wood Ceilings	09 54 26-04
7	09 65 13	Resilient Base and Accessories	09 65 13-02
8	09 65 16	Resilient Flooring	09 65 16-05
9	09 66 23	Resinous Matrix Terrazzo Flooring	09 66 23-04
10	09 67 23	Resinous Flooring	09 67 23-08
11	09 68 13	Tile Carpeting	09 68 13-03
12	09 72 00	Wall Coverings	09 72 00-02
13	09 91 23	Interior Painting	09 91 23-04
14			
15	DIVISION 10 - SPECIALTIES		
16	Section	Title	Pages Thru
17	10 11 00	Visual Display Units	10 11 00-04
18	10 14 00	Signage	10 14 00-02
19	10 21 13.14	Stainless-Steel Toilet Compartments	10 21 13.13-04
20	10 26 00	Wall and Door Protection	10 26 00-02
21	10 28 00	Toilet, Bath and Laundry Accessories	10 28 00-03
22	10 44 13	Fire Protection Cabinets	10 44 13-02
23	10 51 16	Wood Lockers	10 51 16-02
24			
25	DIVISION 11 - EQUIPMENT		
26	Section	Title	Pages Thru
27	11 53 00	Laboratory Equipment	11 53 00-05
28	11 53 01	Laboratory Vacuum Equipment	11 53 01-07
29	11 53 13	High Performance Laboratory Fume Hoods	11 53 13-28
30			
31	DIVISION 12 - FURNISHINGS		
32	Section	Title	Pages Thru
33	12 24 13	Roller Window Shades	12 24 13-03
34	12 35 53	Lab Casework and Other Furnishings	12 35 53-30
35	12 36 61	Solid Surfacing Countertops	12 36 61-02
36	12 36 61.19	Quartz Agglomerate Countertops	12 36 61.19-02
37			
38	DIVISION 14 – CONVEYING SYSTEMS		
39	Section	Title	Pages Thru
40	14 21 21	Elevator Modifications	14 21 21-01
41	14 42 00	Vertical Lifts	14 42 00-03
42			
43	DIVISION 21 – FIRE SUPPRESSION		
44	Section	Title	Pages Thru
45	21 05 00	Common Work Results for Fire Suppression	21 05 00-10
46	21 05 29	Hangers and Supports for Fire Suppression Piping and Equipment	21 05 29-05
47	21 08 00	Commissioning of Fire Suppression	21 08 00-8
48	21 10 00	Water Based Fire Suppression Systems	21 10 00-14
49			
50	DIVISION 22 – PLUMBING		
51	Section	Title	Pages Thru
52	22 05 00	Common Work Results for Plumbing	22 05 00-08
53	22 05 14	Plumbing Specialties	22 05 14-04
54	22 05 15	Piping Specialties	22 05 15-03

1	22 05 23	General Duty Valves for Plumbing Piping	22 05 23-06
2	22 05 29	Hangers and Supports for Plumbing Piping and Equipment	22 05 29-05
3	22 07 00	Plumbing Insulation	22 07 00-07
4	22 08 00	Commissioning of Plumbing	22 08 00-43
5	22 11 00	Facility Water Distribution	22 11 00-08
6	22 13 00	Facility Sanitary Sewerage	22 13 00-06
7	22 42 00	Commercial Plumbing Fixtures	22 42 00-05
8	22 60 00	Gas and Vacuum Systems for Laboratory and Healthcare Facilities	22 60 00-06
9	22 67 00	Processed Water Systems for Laboratory and Healthcare Facilities	22 67 00-04

10

11 **VOLUME 3**

12

13 **DIVISION 23 - HEATING, VENTILATING AND AIR CONDITIONING**

14	Section	Title	Pages Thru
15	23 01 30.51	HVAC Air Duct Cleaning	23 01 30.51-4
16	23 05 00	Common Work Results for HVAC	23 05 00-8
17	23 05 13	Common Motor Requirements for HVAC Equipment	23 05 13-3
18	23 05 15	Piping Specialties	23 05 15-5
19	23 05 23	General-Duty Valves for HVAC Piping	23 05 23-5
20	23 05 29	Hangers and Supports for HVAC Piping and Equipment	23 05 29-6
21	23 05 48	Vibration and Seismic Controls for HVAC Piping and Equipment	23 05 48-3
22	23 05 93	Testing, Adjusting, and Balancing for HVAC	23 05 93-5
23	23 07 00	HVAC Insulation	23 07 00-16
24	23 09 14	Pneumatic and Electric Instrumentation and Control Devices for HVAC	23 09 14-13
25	23 09 15	Direct Digital Control Input/Output Summary Table	23 09 15-8
26	23 09 16	Laboratory Temperature and Airflow Control System	23 09 16-11
27	23 09 23	Direct Digital Control System for HVAC	23 09 23-14
28	23 09 93	Sequence of Operation for HVAC Controls	23 09 93-13
29	23 21 13	Hydronic Piping	23 21 13-11
30	23 25 00	HVAC Water Treatment	23 25 00-5
31	23 31 00	HVAC Ducts and Casings	23 31 00-9
32	23 33 00	Air Duct Accessories	23 33 00-4
33	23 36 00	Air Terminal Units	23 36 00-7
34	23 37 13	Diffusers, Registers and Grilles	23 37 13-5
35	23 82 00	Heating and Cooling Terminal Units	23 82 00-3

36

37 **DIVISION 26 - ELECTRICAL**

38	Section	Title	Pages Thru
39	26 05 00	Common Work Results for Electrical	26 05 00-7
40	26 05 02	Electrical Demolition for Remodeling	26 05 02-3
41	26 05 04	Cleaning, Inspection and Testing of Electrical Equipment	26 05 04-3
42	26 05 19	Low-Voltage Electrical Power Conductors and Cables	26 05 19-5
43	26 05 23	Control-Voltage Electrical Power Cables	26 05 23-3
44	26 05 26	Grounding and Bonding for Electrical Systems	26 05 26-5
45	26 05 29	Hangers and Supports for Electrical Systems	26 05 29-3
46	26 05 33	Raceway and Boxes for Electrical Systems	26 05 33-10
47	26 05 36	Cable Trays for Electrical Systems	26 05 36-5
48	26 05 53	Identification for Electrical Systems	26 05 53-4
49	26 05 73	Short Circuit/Coordination and Arc Flash Study Risk Assessment	26 05 73-5
50	26 08 00	Commissioning of Electrical	26 08 00-45
51	26 09 43	Distributed Digital Lighting Controls	26 09 43-10
52	26 22 00	Low-Voltage Transformers	26 22 00-3
53	26 24 13	Switchboards	26 24 13-5
54	26 24 16	Panelboards	26 24 16-4

1	26 27 02	Equipment Wiring Systems	26 27 02-3
2	26 27 13	Electricity Metering	26 27 13-3
3	26 27 26	Wiring Devices	26 27 26-7
4	26 27 28	Disconnect Switches	26 27 28-2
5	26 28 13	Fuses	26 28 13-1
6	26 28 16	Enclosed Switches and Circuit Breakers	26 28 16-2
7	26 43 13	Surge Protective Devices for Low-Voltage Electrical Power Circuits	26 43 13-3
8	26 51 13	Interior Lighting Fixtures, Lamps, and Ballasts	26 51 13-7

9

10 **DIVISION 27 - COMMUNICATIONS**

11	Section	Title	Pages Thru
12	27 05 53	Identification for Communication Systems	27 05 53-5
13	27 08 00	Commissioning of Communications	27 08 00-20
14	27 08 00.41	AV Systems Commissioning	27 08 00.41-24
15	27 10 00	Structured Cabling	27 10 00-20
16	27 11 00	Communications Room Equipment Room Fittings	27 11 00-3
17	27 41 00	Audio-Video Systems	27 41 00-21
18	27 41 00.1	AV Equipment Schedule	27 41 00.1-3
19	27 41 00.2	Audiovisual Systems Cable Schedule	27 41 00.2-2

20

21 **DIVISION 28 – ELECTRONIC SAFETY AND SECURITY**

22	Section	Title	Pages Thru
23	28 08 00	Commissioning of Electronic Safety and Security	28 08 00-15
24	28 10 00	Access Control	28 10 00-11
25	28 31 00	Fire Detection and Alarm	28 31 00-19

26

27 **DIVISION 32 – EXTERIOR IMPROVEMENTS**

28	Section	Title	Pages Thru
29	32 91 13	Soil Preparation	32 91 13-02
30	32 92 19	Seeding	32 92 19-05

31

32 **DRAWINGS - Bound Separately**

33

34	TITLE	
35	TITLE SHEET	T001

36

37	GENERAL	
38	GENERAL INFORMATION	G003
39	SITE COORDINATION PLAN	G005
40	LIFE SAFETY PLAN - 2ND FLOOR	G102-d
41	LIFE SAFETY PLAN - 4TH FLOOR (LEVEL 3) HAZARDOUS MATERIALS MAQ's	G103

42

43	STRUCTURAL	
44	GENERAL INFORMATION	S001
45	GENERAL NOTES	S002
46	PLAN - 4TH FLOOR	S104.1
47	DETAILS	S884

48

49	HAZARDOUS MATERIALS ABATEMENT	
50	ASBESTOS ABATEMENT PLAN - 1ST FLOOR - DANIELS (NORTH)	H101
51	ASBESTOS ABATEMENT PLAN - 2ND FLOOR - DANIELS (NORTH)	H102

52

53	ARCHITECTURAL DEMOLITION	
54	DEMOLITION PLAN - 2ND FLOOR - DANIELS (NORTH)	AD102.3-d

1	DEMOLITION PLAN - 4TH FLOOR - DANIELS & MATHEWS	AD104.2-d
2	DEMOLITION RCP - 1ST FLOOR - DANIELS (NORTH)	AD301.3-d
3	DEMOLITION RCP - 2ND FLOOR	AD302
4	DEMOLITION RCP - 2ND FLOOR - DANIELS (NORTH)	AD302.3-d
5	DEMOLITION RCP - 2ND FLOOR - DANIELS (CENTRAL)	AD302.4-d
6		
7	ARCHITECTURAL	
8	MOUNTING HEIGHTS	A002
9	PARTITION SCHEDULE	A013
10	FINISH SCHEDULE	A022
11	DOOR SCHEDULE, TYPES, & DETAILS	A038
12	INTERIOR GLAZING SYSTEMS & FLOOR DETAILS	A039
13	2ND FLOOR PLAN, RCP, FINISH PLAN & INTERIOR ELEVATIONS	A102A-d
14	FLOOR PLAN - 4TH FLOOR	A104
15	REFLECTED CEILING PLAN - 4TH FLOOR	A304
16	WALL SECTIONS - 1ST TO 4TH	A524
17	WALL SECTIONS - 1ST TO 4TH	A525
18	WALL SECTIONS - 1ST TO 4TH	A526
19	WALL SECTIONS - 1ST TO 4TH	A527
20	WALL SECTIONS - 1ST TO 4TH	A530
21	ENLARGED PLAN AND DETAILS - STAIR AND LIFT AT 4400C	A606
22	ENLARGED PLANS & ELEVATIONS - ELEVATORS	A611
23	ENLARGED PLANS & DETAILS - ELEVATORS	A612
24	ENLARGED PLANS - TOILET ROOMS	A621
25	INTERIOR ELEVATIONS	A715
26	INTERIOR ELEVATIONS	A716
27	INTERIOR ELEVATIONS - TOILET ROOMS	A741
28	EXTERIOR DETAILS - 2ND TO 4TH FLOORS	A807
29	EXTERIOR DETAILS - 2ND TO 4TH FLOORS	A808
30	EXTERIOR DETAILS - 5TH TO 7TH FLOORS	A809
31	EXTERIOR DETAILS - 5TH TO 7TH FLOORS	A810
32	EXTERIOR DETAILS	A843
33	EXTERIOR DETAILS	A844
34	EXTERIOR DETAILS	A845
35	BUILDING EXPANSION DETAILS	A862
36	FINISH PLAN - 4TH FLOOR TOWER	A904
37	INTERIOR DETAILS - PARTITIONS	A918
38	INTERIOR DETAILS - MILLWORK	A919
39	INTERIOR DETAILS - CEILING	A920
40		
41	SIGNAGE	
42	SIGNAGE PLAN - 2ND & 4TH FLOOR	F104
43	SIGNAGE DETAILS	F901
44	SIGNAGE DETAILS	F902
45	SIGNAGE DETAILS	F905
46		
47	LABORATORY	
48	SYMBOLS AND ABBREVIATIONS	L001A
49	LABORATORY CASEWORK LEGEND & TYPICAL ELEVATIONS	L002A
50	LABORATORY TABLE LEGEND AND DETAILS	L003
51	LAB 4TH FLOOR WEST	L204.1
52	LAB 4TH FLOOR EAST	L204.2
53	LABORATORY SCHEDULES	L601A
54	FUME HOOD SCHEDULE & DETAILS	L602A

1	LABORATORY ELEVATIONS	L705
2	LABORATORY ELEVATIONS	L706
3	LABORATORY DETAILS	L906
4	LABORATORY DETAILS	L907
5		
6	FIRE PROTECTION - DEMOLITION	
7	FIRE PROTECTION - DEMOLITION - 4TH FLOOR	FPD104
8		
9	FIRE PROTECTION	
10	FIRE PROTECTION - SCHEDULES, SYMBOLS AND ABBREVIATIONS	FP000
11	FIRE PROTECTION - 2ND FLOOR - DANIELS	FP102-d
12	FIRE PROTECTION - 4TH FLOOR	FP104
13		
14	PLUMBING	
15	PLUMBING - SYMBOLS, ABBREVIATIONS AND NOTES	P000
16	PLUMBING - SCHEDULES AND CALCULATIONS	P001
17	PLUMBING - FIRST FLOOR - DANIELS	P101-d
18	PLUMBING - PARTIAL 2ND FLOOR - DANIELS	P102-d.1
19	PLUMBING - PARTIAL 2ND FLOOR - DANIELS - LAB GAS	P102-d.2
20	PLUMBING - 2ND FLOOR - WASTE - (EAST)	P102.2
21	PLUMBING - 4TH FLOOR - WASTE - (WEST)	P104.1
22	PLUMBING - 4TH FLOOR - WASTE - (EAST)	P104.2
23	PLUMBING - 4TH FLOOR - WATER/LAB GAS - (WEST)	P104.3
24	PLUMBING - 4TH FLOOR - WATER/LAB GAS - (EAST)	P104.4
25	PLUMBING - DETAILS	P300
26	PLUMBING - DRAIN WASTE & VENT ISOMETRIC	P400
27	PLUMBING - ACID WASTE ISOMETRIC	P500
28	PLUMBING - WATER ISOMETRIC	P600
29	PLUMBING - LAB GAS ISOMETRIC	P700
30		
31	COMMUNICATIONS DEMOLITION	
32	COMMUNICATIONS DEMO PLAN - 2ND FLOOR - DANIELS	QD102.1-d
33		
34	COMMUNICATIONS	
35	COMMUNICATIONS SYMBOLS AND ABBREVIATIONS	Q001
36	COMMUNICATIONS PLAN - 2ND FLOOR - DANIELS	Q102.1-d
37	COMMUNICATIONS PLAN 4TH	Q104
38	COMMUNICATIONS ROOM 4432 ENLARGED FLOOR PLAN AND ELEVATIONS	Q204
39	COMMUNICATIONS DETAILS	Q401
40	SECURITY DETAILS	Q402
41		
42	AUDIO VISUAL	
43	AV SYMBOLS AND ABBREVIATIONS	AV000
44	AV PLAN - 2ND FLOOR - DANIELS	AV102.1-d
45	AV PLAN - 4TH FLOOR	AV104
46	AUDIOVISUAL RISERS	AV301
47	AUDIOVISUAL ENLARGED VIEWS - CONFERENCE ROOM 4444	AV401
48	AUDIOVISUAL ENLARGED VIEWS - CONFERENCE ROOM 4421	AV402
49	SYSTEM DIAGRAMS	AV609
50	AUDIOVISUAL DETAILS	AV801
51		
52	MECHANICAL DEMOLITION	
53	MECHANICAL DEMOLITION PLAN 2ND FLOOR DANIELS	MD102.3-d
54	MECHANICAL DEMO PLAN 4TH (WEST)	MD104.1

1	MECHANICAL DEMO PLAN 4TH (EAST)	MD104.2
2		
3	MECHANICAL	
4	MECHANICAL SYMBOLS AND ABBREVIATIONS	M001
5	MECHANICAL SECTIONS	M300
6	MECHANICAL FLOW DIAGRAMS	M700
7	BUILDING AUTOMATION SYSTEM ARCHITECTURE	M701
8	ROOM CONTROL TYPICAL DIAGRAMS	M710
9	ROOM CONTROL TYPICAL DIAGRAMS	M711
10	MECHANICAL DETAILS	M800
11	MECHANICAL DETAILS	M801
12	MECHANICAL DETAILS	M802
13	MECHANICAL SCHEDULES	M900
14	MECHANICAL SCHEDULES	M901
15		
16	MECHANICAL DUCTWORK	
17	MECHANICAL DUCTWORK PLAN 2ND FLOOR DANIELS NORTH	MH102.3-d
18	MECHANICAL DUCTWORK PLAN 4TH (WEST)	MH104.1
19	MECHANICAL DUCTWORK PLAN 4TH (EAST)	MH104.2
20		
21	MECHANICAL PIPING	
22	MECHANICAL PIPING PLAN - 2ND FLOOR DANIELS NORTH	MP102.1-d
23	MECHANICAL PIPING PLAN 4TH (WEST)	MP104.1
24	MECHANICAL PIPING PLAN 4TH (EAST)	MP104.2
25		
26	ELECTRICAL DEMOLITION	
27	ELECTRICAL DEMOLITION PLAN - 2ND FLOOR	ED102
28	ELECTRICAL DEMOLITION PLAN - 2ND FLOOR - DANIELS	ED102.1-d
29	ELECTRICAL DEMOLITION PLAN - 4TH FLOOR	ED104
30	DEMO MOTOR SCHEDULE	ED902
31		
32	ELECTRICAL	
33	ELECTRICAL SYMBOLS AND ABBREVIATIONS	E001
34	ELECTRICAL POWER PLAN - 2ND FLOOR DANIELS (NORTH)	E102.5-d
35	ELECTRICAL POWER PLAN 4TH (WEST)	E104.1
36	ELECTRICAL POWER PLAN 4TH (EAST)	E104.2
37	ELECTRICAL LIGHTING PLAN - 2ND FLOOR - DANIELS	E202.1-d
38	ELECTRICAL LIGHTING PLAN - 4TH FLOOR	E204
39	ELECTRICAL SYSTEMS PLAN - 2ND FLOOR - DANIELS	E302.1-d
40	ELECTRICAL SYSTEMS PLAN - 4TH FLOOR	E304
41	NORMAL POWER SERVICE ONE-LINE	E701
42	NORMAL POWER PARTIAL ONE-LINE - SUB-BASEMENT - 4TH FLOOR	E702
43	EMERGENCY POWER PARTIAL ONE-LINE - SUB-BASEMENT - BASEMENT	E704
44	EMERGENCY POWER PARTIAL ONE-LINE -1ST FLOOR TO 9TH FLOOR	E705
45	DANIELS ONE-LINE DEMOLITION PLAN	E706
46	DANIELS NORMAL POWER PARTIAL ONE-LINE	E707
47	ELECTRICAL GROUNDING RISER	E708
48	FIRE ALARM RISER	E709
49	FIRE ALARM MATRIX	E710
50	ELECTRICAL DETAILS	E812
51	ELECTRICAL DETAILS	E813
52	FEEDER SCHEDULE	E901
53	LIGHTING SCHEDULE	E904
54	ELECTRICAL PANEL SCHEDULE	E920

1	ELECTRICAL PANEL SCHEDULE	E921
2	ELECTRICAL PANEL SCHEDULE	E922
3	ELECTRICAL PANEL SCHEDULE - DANIELS	E923-d
4		

1 **GLAZING**

2 Fire Rated Glazing, compatible with framing system, as specified in Section 08 80 00.

3 **FINISHES**

4 Finishing: Apply factory finish to surfaces that will be exposed in completed assemblies.

5 Touch-up surfaces cut during fabrication so that no natural metal surfaces are visible in completed
6 assemblies, including joint edges.

7 Finish: Polyester powder coated to AAMA 2604 standards. RAL color to match P-4.

8 **PART 3 EXECUTION**

9 **INSTALLATION**

10 Install wall system in accordance with limitations of fire rating and with manufacturer's instructions.

11 Install framed glazing assemblies in accordance with NFPA 80 and requirements of local authorities having
12 jurisdiction.

13 Attach to structure to permit sufficient adjustment to accommodate construction tolerances and other irregularities.

14 Provide alignment attachments and shims to permanently fasten system to building structure.

15 Align assembly plumb and level, free of warp or twist. Maintain assembly dimensional tolerances, aligning with
16 adjacent work.

17 Touch-up minor damage to factory applied finish; replace components that cannot be satisfactorily repaired.

18 **TOLERANCES**

19 Maximum Variation from Plumb: 1/16 inch every 3 feet non-cumulative or 1/2 inch per 100 ft, whichever is less.

20 Maximum Misalignment of Two Adjoining Members Abutting in Plane: 1/32 inch.

21 Sealant Space Between Mullions and Adjacent Construction: Maximum of 3/4 inch and minimum of 1/4 inch.

22 **CLEANING**

23 Remove protective material from pre-finished surfaces.

24 Wash down surfaces with a solution of mild detergent in warm water, applied with soft, clean wiping cloths. Take
25 care to remove dirt from corners. Wipe surfaces clean.

26 **END OF SECTION**

1 **FIELD CONDITIONS**

2 Environmental Limitations: Comply with resinous flooring manufacturer's written instructions for substrate
3 temperature, ambient temperature, moisture, ventilation, and other conditions affecting resinous flooring application.

4 Lighting: Provide permanent lighting or, if permanent lighting is not in place, simulate permanent lighting
5 conditions during resinous flooring application.

6 Close spaces to traffic during resinous flooring application and for 24 hours after application unless manufacturer
7 recommends a longer period.

8 **PART 2 - PRODUCTS**

9 **PERORMANCE REQUIREMENTS**

10 VOC Content of Liquid-Applied Flooring Components: Not more than 100 g/L when calculated according to 40
11 CFR 59, Subpart D (EPA Method 24).

12 Flammability: Self-extinguishing according to ASTM D 635.

13 **MANUFACTURERS**

14 Source Limitations: Obtain primary resinous flooring materials, including primers, resins, hardening agents,
15 grouting coats, and topcoats, from single source from single manufacturer for each flooring type. Obtain secondary
16 materials, including patching and fill material, joint sealant, and repair materials, of type and from manufacturer
17 recommended in writing by manufacturer of primary materials.

18 Basis-of-Design Product: Subject to compliance with requirements, provide products indicated on Interior
19 Finish Schedule or comparable product by one of the following:

- 20 BASF Construction Chemicals, Inc.; BASF Building Systems.
- 21 Crossfield Products Corp.; Dex-O-Tex.
- 22 DUDICK Inc.
- 23 Dur-A-Flex, Inc.
- 24 Key Resin Company.
- 25 ITW Polymers Sealants North America (formerly Pacific Polymers, Inc.).
- 26 Sika Corporation U.S.
- 27 Stonhard, Inc.
- 28 Tnemec Company, Inc.

29 **RESINOUS FLOORING (RF-3)**

30 Resinous Flooring System: Lab floors.

31 Basis of Design Product: ~~Stonchem 802Stongard EFX.~~

32 System Characteristics:

- 33 Color and Pattern: Choose from Mfg. Standards
- 34 Wearing Surface: Standard smooth.
- 35 Overall System Thickness: 3/16 to 1/4 inch. ~~80 mils~~
- 36 ~~Moisture Tolerance: Can be applied to concrete up to 90 percent Rh.~~

37 System Components.

38 Waterproofing:

39 Material Design Basis: Stonproof ME7.

1 Resin: Urethane.
2 Formulation Description: High solids, elastomeric
3 Substrate Priming: Two-coat application per product directions.
4 Application Method: Notched squeegee.
5 Thickness of Coat: 30-40 mils.
6 Number of Coats: one.

7 Bonding Layer:

8 Material Design Basis: Stonhard Standard Primer.
9 Resin: Epoxy.
10 Formulation Description: 100 percent solids.
11 Application Method: Squeegee and back roll.
12 Broadcast: Texture #3 (#46 Grit silica) to rejection
13 Number of Coats: one.

14 Primer:

15 Material Design Basis: Stonchem 800 Primer.
16 Resin: Vinyl ester.
17 Formulation Description: high solids.
18 Application Method: Squeegee and back roll.
19 Number of Coats: one.

20 Mortar Grout:

21 Material Design Basis: Stonchem 802 Series Mortar.
22 Resin: Vinyl ester.
23 Formulation Description: consisting of vinyl ester resin, curing agent and finely divided mineral
24 composite aggregate.
25 Application Method: Notched squeegee.
26 Thickness: 15 mils.
27 Number of Coats: one.
28 Aggregates: Mineral composite aggregate.

29 Top Coat:

30 Material Design Basis: Stonchem 802 Series Topcoat.
31 Resin: Vinyl Ester.
32 Formulation Description: Highly impermeable, mineral composite, vinyl ester.
33 Type: Pigmented gray only.
34 Thickness: 10 mils.
35 Number of Coats: one.

36 **RESINOUS FLOORING (RF-4)**

37 Resinous Flooring System: Common area system.

38 Basis of Design Product: ~~Stongard~~ Stoncrete EFX.

39 System Characteristics:

40 Color and Pattern: Choose from Mfg. Standards
41 Wearing Surface: Standard smooth.
42 Overall System Thickness: 3/16 to 1/4 inch.
43 ~~Moisture Tolerance: Can be applied to concrete up to 90 percent Rh.~~

1 System Components.

2 Waterproofing:

3 Material Design Basis: Stonproof ME7.

4 Resin: Urethane.

5 Formulation Description: High solids, elastomeric

6 Substrate Priming: Two-coat application per product directions.

7 Application Method: Notched squeegee.

8 Thickness of Coat: 30-40 mils.

9 Number of Coats: one.

10 Primer Coat:

11 Material Design Basis: Stonhard Groutcoat.

12 Resin: Epoxy.

13 Formulation Description: two-component, 100 percent solids.

14 Application Method: squeegee and back roll.

15 Number of Coats: one.

16 Mortar Base:

17 Material Design Basis: Stonclad EFX.

18 Resin: Urethane.

19 Formulation Description: four-component, 100 percent solids.

20 Application Method: Metal Trowel.

21 Thickness: Nominal 3/16 to 1/4 inch, single lift.

22 Aggregates: Pigmented and natural blended aggregates.

23 After curing, grind to manufacturer's standards.

24 Grout Coat:

25 Material Design Basis: Stoncrete EFX Groutcoat.

26 Resin: Epoxy.

27 Formulation Description: Two-component, 100 percent solids.

28 Type: Clear.

29 Application Method: Squeegee and roller.

30 Finish: Standard.

31 Number of Coats: one.

32 Seal Coat:

33 Material Design Basis: Stonkote CE4.

34 Resin: Epoxy.

35 Formulation Description: Two-component, 100 percent solids.

36 Type: Clear.

37 Finish: Standard.

38 Number of Coats: one.

39 Top Coat:

40 Material Design Basis: Stonseal SK6-SF.

41 Resin: Aliphatic Urethane.

42 Formulation Description: 100 percent solids.

43 Type: Clear.

- 1 Finish: Satin.
2 Number of Coats: one.
- 3 **RESINOUS FLOORING (RF-5)**
4 Resinous Flooring System: Maintenance/Janitorial system.
- 5 Basis of Design Product: Stongard MR.
- 6 System Characteristics:
- 7 Color and Pattern: Choose from Mfg. Standards
8 Wearing Surface: Standard topcoat.
9 Integral Cove Base: Height, 6-inches.
10 Overall System Thickness: 40 mils.
11 ~~Moisture Tolerance: Can be applied to concrete up to 90 percent Rh.~~
- 12 System Components.
- 13 Primer Coat One:
- 14 Material Design Basis: Stonhard Standard Primer.
15 Resin: epoxy.
16 Formulation Description: 100 percent solids.
17 Application Method: squeegee and back roll.
18 Number of Coats: one.
- 19 Primer Coat Two:
- 20 Material Design Basis: Stonhard SL Primer.
21 Resin: Urethane.
22 Formulation Description: 100 percent solids.
23 Application Method squeegee and back-roll application over wet Standard Primer coat.
24 Number of Coats: one.
- 25 Base Coat:
- 26 Material Design Basis: Stonproof ME7.
27 Resin: Urethane.
28 Formulation Description: 100 percent solids.
29 Application Method: Notched squeegee.
30 Thickness of Coat: 30-mils.
31 Number of Coats: one.
- 32 Top Coat:
- 33 Material Design Basis: Stonkote GS4.
34 Resin: Epoxy.
35 Formulation Description: 100 percent solids.
36 Type: Pigmented.
37 Finish: Lightly textured.
38 Number of Coats: one.
- 39 **RESINOUS FLOORING (RF-6)**
40 Resinous Flooring System: Waterproofing layer for use under ~~other flooring~~carpet.

1 Basis of Design Product: Stongard MR.

2 System Characteristics:

3 Color and Pattern: Choose from Mfg. Standards

4 Wearing Surface: Standard topcoat.

5 Integral Cove Base: Height, 6-inches.

6 Overall System Thickness: 40 mils.

7 System Components.

8 Primer Coat One:

9 Material Design Basis: Stonhard Standard Primer.

10 Resin: epoxy.

11 Formulation Description: 100 percent solids.

12 Application Method: squeegee and back roll.

13 Number of Coats: one.

14 Primer Coat Two:

15 Material Design Basis: Stonhard SL Primer.

16 Resin: Urethane.

17 Formulation Description: 100 percent solids.

18 Application Method squeegee and back-roll application over wet Standard Primer coat.

19 Number of Coats: one.

20 Base Coat:

21 Material Design Basis: Stonproof ME7.

22 Resin: Urethane.

23 Formulation Description: 100 percent solids.

24 Application Method: Notched squeegee.

25 Thickness of Coat: 30-mils.

26 Number of Coats: one.

27 Top Coat:

28 Material Design Basis: Stonkote GS4.

29 Resin: Epoxy.

30 Formulation Description: 100 percent solids.

31 Type: Pigmented.

32 Finish: Lightly textured.

33 Number of Coats: one.

34 **ACCESORIES**

35 Patching and Fill Material: Resinous product of or approved by resinous flooring manufacturer and recommended
36 by manufacturer for application indicated.

37 Joints Filler/Crack Isolation: Elastomeric material with 10 oz, engineered, fiberglass fabric.

38 Patching Mortar: Two-component 100 percent solids epoxy patching mortar.

39 Pitching & Leveling: Type recommended or produced by resinous flooring manufacturer for type of service and
40 joint condition indicated.

- 1 Basis of Design; Stonset TG5: a three-component quick-setting epoxy grout.
2 Basis of Design; Stonclad GS: four-component epoxy mortar.
- 3 Joint Sealant: Type recommended or produced by resinous flooring manufacturer for type of service and joint
4 condition indicated.
- 5 Stonflex MP7 with Stonflex CR9: a two-component elastomeric urethane sealant with fluoro-elastomeric
6 sealer applied within Chemical Resistant Lining area.
7 Stonflex MP7: A two-component elastomeric urethane sealant.

8 **PART 3 - EXECUTION**

9 **PREPARATION**

10 Prepare and clean substrates according to resinous flooring manufacturer's written instructions for substrate
11 indicated. Provide clean, dry substrate for resinous flooring application.

12 Concrete Substrates: Provide sound concrete surfaces free of laitance, glaze, efflorescence, curing compounds,
13 form-release agents, dust, dirt, grease, oil, and other contaminants incompatible with resinous flooring.

14 Roughen concrete substrates as follows:

15 Shot-blast surfaces with an apparatus that abrades the concrete surface, contains the dispensed shot within
16 the apparatus, and recirculates the shot by vacuum pickup.

17 Comply with ASTM C 811 requirements unless manufacturer's written instructions are more stringent.

18 Repair damaged and deteriorated concrete according to resinous flooring manufacturer's written instructions.

19 Verify that concrete substrates are dry and moisture-vapor emissions are within acceptable levels according to
20 manufacturer's written instructions.

21 Relative Humidity Test: Use in situ probes, ASTM F 2170. Proceed with installation only after substrates
22 have a relative humidity level measurement that does not exceed coating manufacturer's limits.

23 Provide one test for every 200 sq. ft. of flooring, or fraction there of.

24 Alkalinity and Adhesion Testing: Verify that concrete substrates have pH within acceptable range. Perform
25 tests recommended by manufacturer. Proceed with application only after substrates pass testing.

26 Patching and Filling: Use patching and fill material to fill holes and depressions in substrates according to
27 manufacturer's written instructions.

28 Joint Treatment: Treat joints and other nonmoving substrate cracks to prevent cracks from reflecting through
29 resinous flooring according to manufacturer's written instructions.

30 Resinous Materials: Mix components and prepare materials according to resinous flooring manufacturer's written
31 instructions.

32 **APPLICATION**

33 Refer to drawings and Finish Schedule for locations of each type of resinous flooring.

34 Apply components of resinous flooring system according to manufacturer's written instructions to produce a
35 uniform, monolithic wearing surface of thickness indicated.

36 Coordinate application of components to provide optimum adhesion of resinous flooring system to substrate,
37 and optimum intercoat adhesion.

1 Cure resinous flooring components according to manufacturer's written instructions. Prevent contamination
2 during application and curing processes.
3 Expansion and Isolation Joint Treatment: At substrate expansion and isolation joints, comply with resinous
4 flooring manufacturer's written instructions.

5 Primer: Apply primer over prepared substrate at manufacturer's recommended spreading rate.




6 Topcoats: Apply topcoats in number indicated for flooring system and at spreading rates recommended in writing by
7 manufacturer and to produce wearing surface indicated.

8 **PROTECTION**

9 Protect resinous flooring from damage and wear during the remainder of construction period. Use protective
10 methods and materials, including temporary covering, recommended in writing by resinous flooring manufacturer.

11
12


END OF SECTION 09 67 23

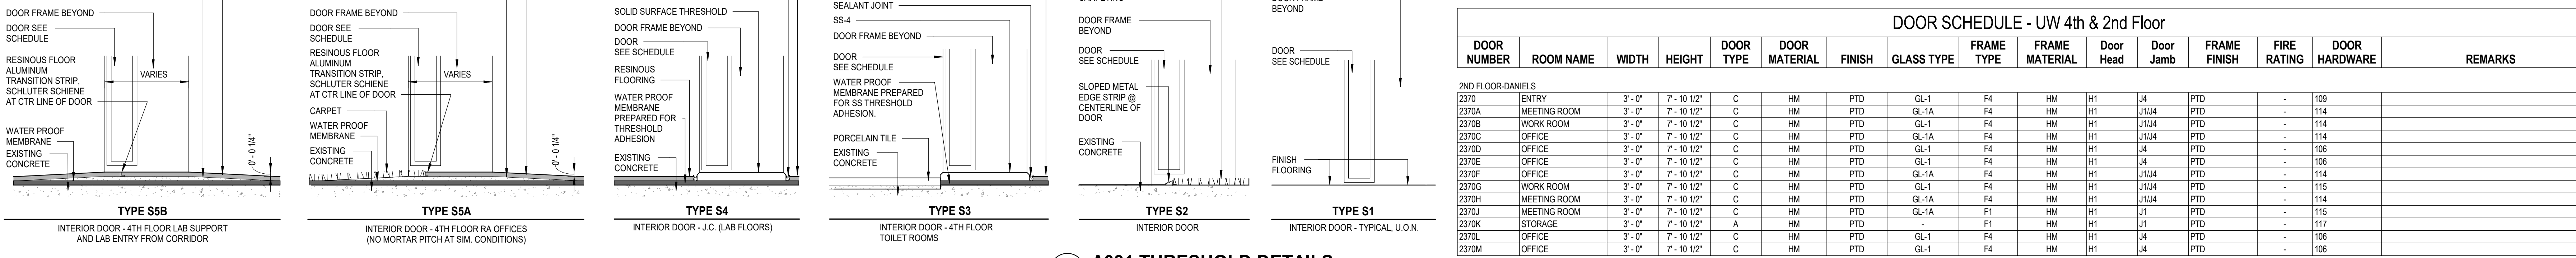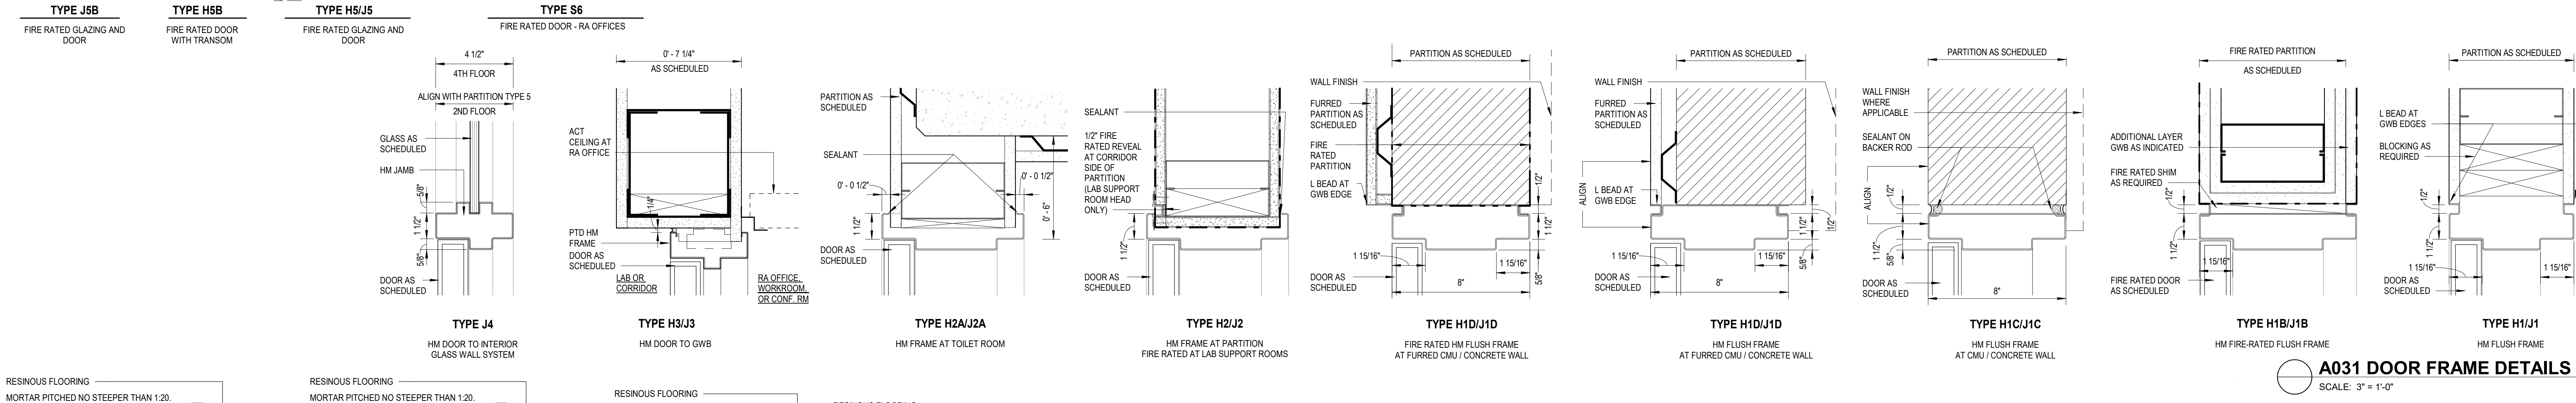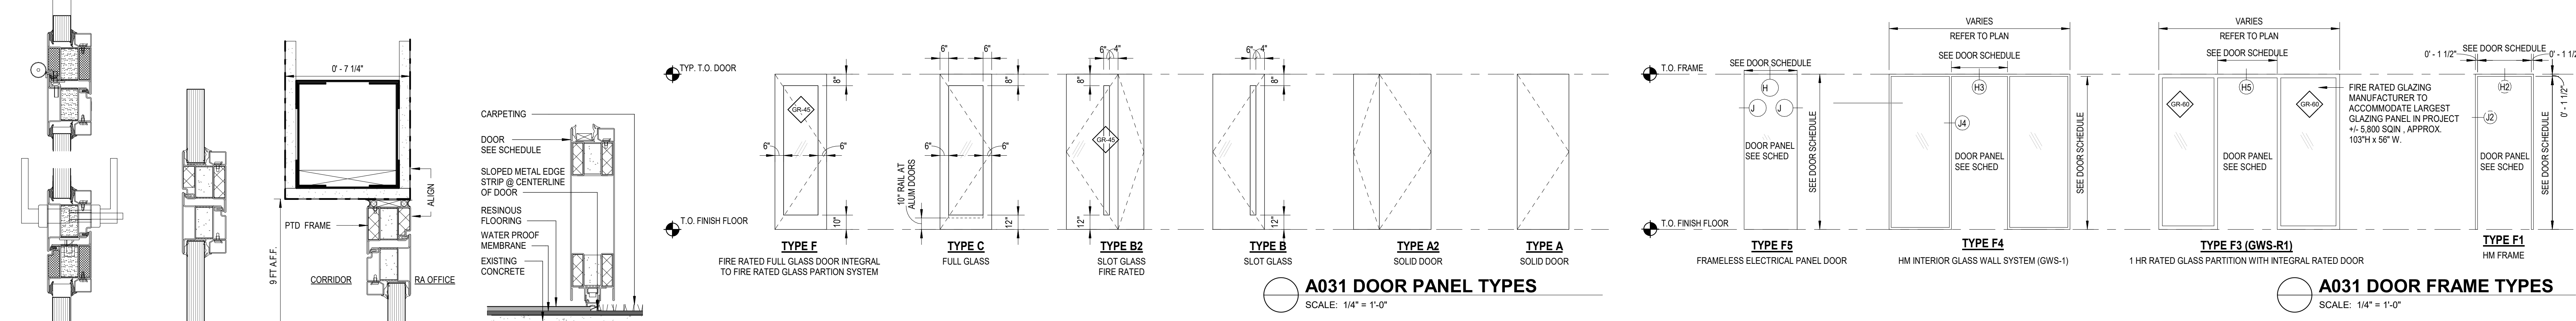


DOOR SCHEDULE - UW 4th & 2nd Floor

DOOR NUMBER	ROOM NAME	WIDTH	HEIGHT	DOOR TYPE	DOOR MATERIAL	FINISH	GLASS TYPE	FRAME TYPE	FRAME MATERIAL	Door Head	Door Jamb	FRAME FINISH	FIRE RATING	DOOR HARDWARE	REMARKS
2370	ENTRY	3'-0"	7'-10 1/2"	C	HM	PTD	GL-1	F4	HM	H1	J4	PTD	-	109	
2370A	MEETING ROOM	3'-0"	7'-10 1/2"	C	HM	PTD	GL-1A	F4	HM	H1	J1J4	PTD	-	114	
2370B	WORK ROOM	3'-0"	7'-10 1/2"	C	HM	PTD	GL-1	F4	HM	H1	J1J4	PTD	-	114	
2370C	OFFICE	3'-0"	7'-10 1/2"	C	HM	PTD	GL-1A	F4	HM	H1	J1J4	PTD	-	114	
2370D	OFFICE	3'-0"	7'-10 1/2"	C	HM	PTD	GL-1	F4	HM	H1	J4	PTD	-	106	
2370E	OFFICE	3'-0"	7'-10 1/2"	C	HM	PTD	GL-1	F4	HM	H1	J4	PTD	-	106	
2370F	OFFICE	3'-0"	7'-10 1/2"	C	HM	PTD	GL-1A	F4	HM	H1	J1J4	PTD	-	114	
2370G	WORK ROOM	3'-0"	7'-10 1/2"	C	HM	PTD	GL-1	F4	HM	H1	J1J4	PTD	-	115	
2370H	MEETING ROOM	3'-0"	7'-10 1/2"	C	HM	PTD	GL-1A	F4	HM	H1	J1J4	PTD	-	114	
2370I	MEETING ROOM	3'-0"	7'-10 1/2"	C	HM	PTD	GL-1A	F1	HM	H1	J1	PTD	-	115	
2370K	STORAGE	3'-0"	7'-10 1/2"	A	HM	PTD	F1	F1	HM	H1	J1	PTD	-	117	
2370L	OFFICE	3'-0"	7'-10 1/2"	C	HM	PTD	GL-1	F4	HM	H1	J4	PTD	-	106	
2370M	OFFICE	3'-0"	7'-10 1/2"	C	HM	PTD	GL-1	F4	HM	H1	J4	PTD	-	106	

DOOR NUMBER	ROOM NAME	WIDTH	HEIGHT	DOOR TYPE	DOOR MATERIAL	FINISH	GLASS TYPE	FRAME TYPE	FRAME MATERIAL	Door Head	Door Jamb	FRAME FINISH	FIRE RATING	DOOR HARDWARE	REMARKS	
4400A	STAIR & LIFT	3'-6"	7'-0"	B	A	HM	PTD	GR-180	F1	HM	H1D	H1D	PTD	180 MN	100	AUTOMATIC OPERATOR, CR
4400TA	CORRIDOR	4'-3"	8'-11 1/2"	A	WD	PTD	-	-	SIM 1A038	SIM 2A038	-	-	-	120	-	
4400TB	CORRIDOR	4'-3"	8'-11 1/2"	A	WD	PTD	-	-	-	-	-	-	-	118	-	
4400TC	CORRIDOR	4'-3"	8'-11 1/2"	A	WD	PTD	-	-	-	-	-	-	-	119	-	
4400TD	CORRIDOR	4'-3"	8'-11 1/2"	A	WD	PTD	-	-	-	-	-	-	-	120	-	
4400TE	CORRIDOR	4'-3"	8'-11 1/2"	A	WD	PTD	-	-	-	-	-	-	-	120	-	
4400TF	CORRIDOR	4'-3"	8'-11 1/2"	A	WD	PTD	-	-	-	-	-	-	-	118	-	
4400TG	CORRIDOR	4'-3"	8'-11 1/2"	A	WD	PTD	-	-	-	-	-	-	-	119	-	
4400TH	CORRIDOR	4'-3"	8'-11 1/2"	A	WD	PTD	-	-	-	-	-	-	-	120	-	
4403	LAB SUPPORT	4'-6"	8'-10"	B2	HM	PTD	GR-45	F1	HM	H2	J2	PTD	45 MN	101		
4405A	OFFICE	3'-0"	8'-9"	F	HM	PTD	GR-45	GWS-R1	MFR SYSTEM	H5	J5B	PTD	45 MN	111		
4405B	OFFICE	3'-0"	8'-10"	C	HM	PTD	GL-1	F4	HM	H3	J3J4	PTD	-	112		
4407	LAB SUPPORT	4'-6"	8'-10"	B2	HM	PTD	GR-45	F1	HM	H2	J2	PTD	45 MN	101		
4409A	OFFICE	3'-0"	8'-9"	F	HM	PTD	GR-45	GWS-R1	MFR SYSTEM	H5	J5B	PTD	45 MN	111		
4409B	OFFICE	3'-0"	8'-10"	C	HM	PTD	GL-1	F4	HM	H3	J3J4	PTD	-	112		
4410	R.O. WATER	4'-6"	8'-10"	A2	HM	PTD	F1	F1	HM	H2	J2	PTD	-	102		
4415	LABORATORY	6'-0"	8'-9"	F	HM	PTD	GR-45	GWS-R1	MFR SYSTEM	H5B	J5B	PTD	45 MN	99		
4417A	OFFICE	3'-0"	8'-10"	C	HM	PTD	GL-1A	F4	HM	H3	J4	PTD	-	107		
4417B	WORK ROOM	3'-0"	8'-10"	C	HM	PTD	GL-1	F4	HM	H3	J4	PTD	-	106		
4419A	OFFICE	3'-0"	8'-10"	C	HM	PTD	GL-1A	F4	HM	H3	J4	PTD	-	107		
4419B	WORK ROOM	3'-0"	8'-10"	C	HM	PTD	GL-1	F4	HM	H3	J4	PTD	-	106		
4421A	CONFERENCE ROOM	3'-0"	8'-10"	F	HM	PTD	GL-10	F4	HM	H1	J4	PTD	-	108		
4421B	CONFERENCE ROOM	3'-0"	8'-10"	F	HM	PTD	GL-10	F4	HM	H1	J4	PTD	-	108		
4423A	OFFICE	3'-0"	8'-10"	C	HM	PTD	GL-1A	F4	HM	H3	J4	PTD	-	107		
4423B	WORK ROOM	3'-0"	8'-10"	C	HM	PTD	GL-1	F4	HM	H3	J4	PTD	-	106		
4424	STAIR & LIFT	4'-0"	7'-0"	A2	HM	PTD	F1	F1	HM	H2A	J2	PTD	-	103		
4425A	OFFICE	3'-0"	8'-10"	C	HM	PTD	GL-1A	F4	HM	H3	J4	PTD	-	107		
4425B	WORK ROOM	3'-0"	8'-10"	C	HM	PTD	GL-1	F4	HM	H3	J4	PTD	-	106		
4428	STORAGE	3'-0"	7'-0"	A	HM	PTD	-	F1	HM	H2A	J2	PTD	-	104		
4429	LABORATORY	6'-0"	8'-10"	F	HM	PTD	GR-45	GWS-R1	MFR SYSTEM	H5B	J5B	PTD	45 MN	99		
4429A	LABORATORY	3'-0"	8'-10"	B	HM	PTD	GR-45	F1	HM	H2	J2	PTD	45 MN	113		
4429B	LABORATORY	3'-0"	8'-10"	B	HM	PTD	GR-45	F1	HM	H2	J2	PTD	45 MN	113		
4431A	OFFICE	3'-0"	8'-9"	F	HM	PTD	GR-45	GWS-R1	MFR SYSTEM	H5	J5B	PTD	45 MN	111		
4431B	OFFICE	3'-0"	8'-10"	C	HM	PTD	GL-1	F4	HM	H3	J3J4	PTD	-	112		
4433	LAB SUPPORT	4'-6"	8'-10"	B2	HM	PTD	GR-45	F1	HM	H2	J2	PTD	45 MN	101		
4435	LAB SUPPORT	4'-6"	8'-10"	B2	HM	PTD	GR-45	F1	HM	H2	J2	PTD	45 MN	101		
4438	WOMEN	3'-0"	8'-10"	A	HM	PTD	F1	F1	HM	H2A	J2A	PTD	-	116	10" SSTL KICK PLATE	
4439A	OFFICE	3'-0"	8'-9"	F	HM	PTD	GR-45	GWS-R1	MFR SYSTEM	H5	J5B	PTD	45 MN	111		
4439B	OFFICE	3'-0"	8'-10"	C	HM	PTD	GL-1	F4	HM	H3	J4	PTD	-	112		
4440	MEN	3'-0"	8'-10"	A	HM	PTD	-	F1	HM	H2A	J2A	PTD	-	116	10" SSTL KICK PLATE	
4443	LAB SUPPORT	4'-6"	8'-10"	B2	HM	PTD	GR-45	F1	HM	H2	J2	PTD	45 MN	101		
4444A	CONFERENCE ROOM	3'-0"	8'-10"	F	HM	PTD	GL-10	F4	HM	H3	J3J4	PTD	-	110		
4444B	CONFERENCE ROOM	3'-0"	8'-10"	F	HM	PTD	GL-10	F4	HM	H3	J3J4	PTD	-	110		
4445A	OFFICE	3'-0"	8'-9"	F	HM	PTD	GR-45	GWS-R1	MFR SYSTEM	H5	J5B	PTD	45 MN	111		
4445B	OFFICE	3'-0"	8'-10"	C	HM	PTD	GL-1	F4	HM	H3	J4	PTD	-	112		
4448	JANITOR	3'-6"	8'-10"	A	HM	PTD	F1	F1	HM	H2	J2	PTD	-	105		
4449A	OFFICE	3'-0"	8'-9"	F	HM	PTD	GR-45	GWS-R1	MFR SYSTEM	H5	J5B	PTD	45 MN	111		
4449B	OFFICE	3'-0"	8'-10"	C	HM	PTD	GL-1	F4	HM	H3	J4	PTD	-	112		
4451	LAB SUPPORT	4'-6"	8'-10"	B2	HM	PTD	GR-45	F1	HM	H2	J2	PTD	45 MN	101		
E-4400A	STAIR 8	3'-0"	8'-10"	A-ETR	HMETR	PTD	-	EXISTING	HMETR	EXISTING	EXISTING	PTD	90 MN	117/ETR	EXISTING DOOR TO REMAIN. PAINT DOOR AND FRAME.	
E-4400B	STAIR 9	3'-0"	8'-10"	A-ETR	HMETR	PTD	-	EXISTING	HMETR	EXISTING	EXISTING	PTD	90 MN	117/ETR	EXISTING DOOR TO REMAIN. PAINT DOOR AND FRAME.	
E-4432	ELECTRICAL	3'-0"	8'-10 1/2"	A-ETR	HMETR	PTD	-	EXISTING	HMETR	EXISTING	EXISTING	PTD	90 MN	117/ETR	EXISTING DOOR TO REMAIN. PAINT DOOR AND FRAME.	
E-4434	TELE-DATA	3'-0"	8'-10 1/2"	A-ETR	HMETR	PTD	-	EXISTING	HMETR	EXISTING	EXISTING	PTD	90 MN	117/ETR	EXISTING DOOR TO REMAIN. PAINT DOOR AND FRAME.	

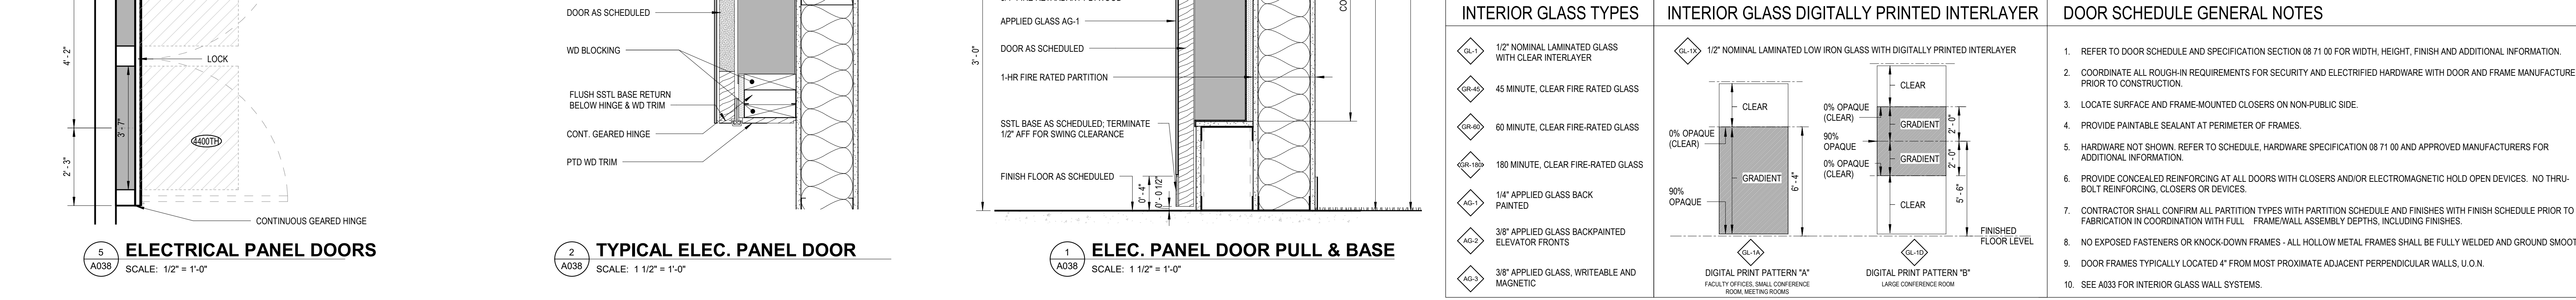

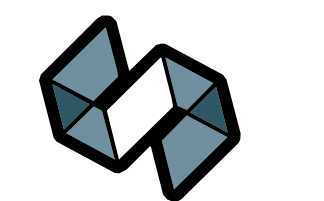


STRANG

ARCHITECTURE
ENGINEERING
INTERIOR DESIGN

811 East Washington Ave, Suite 200
Madison, WI 53703
Tel: 608.278.9500


Consultant:
ballinger

833 Chestnut Street / Suite 1400
Philadelphia, PA 19107
Tel: 215.648.0600 / 1
Tel: 215.648.0111
ballinger.com

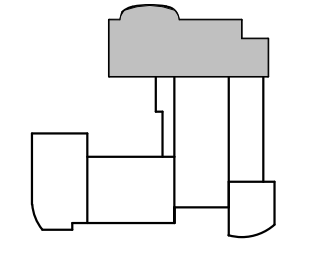

KEY PLAN

The Board of Regents of the
University of Wisconsin on behalf of
the University of Wisconsin - Madison

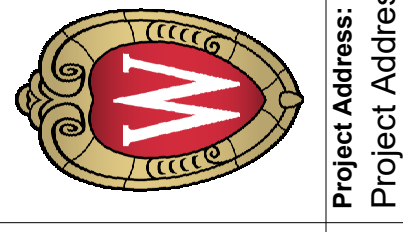

Project Address:


Project Title:
**CHEMISTRY 2ND AND 4TH FLOOR LAB
RENOVATION**
Agency / Institution:
UNIVERSITY OF WISCONSIN-MADISON


Project Address:

Sheet Title:
REFLECTED CEILING PLAN - 4TH FLOOR

Revisions		
No.	Date	Description
2	9/19/2023	ADDENDUM NO. 2

Graphic Scale	VARIES
UWSA#	A-22-015
Set Type	BD
Date Issued	09/19/2023
Sheet Number	A304

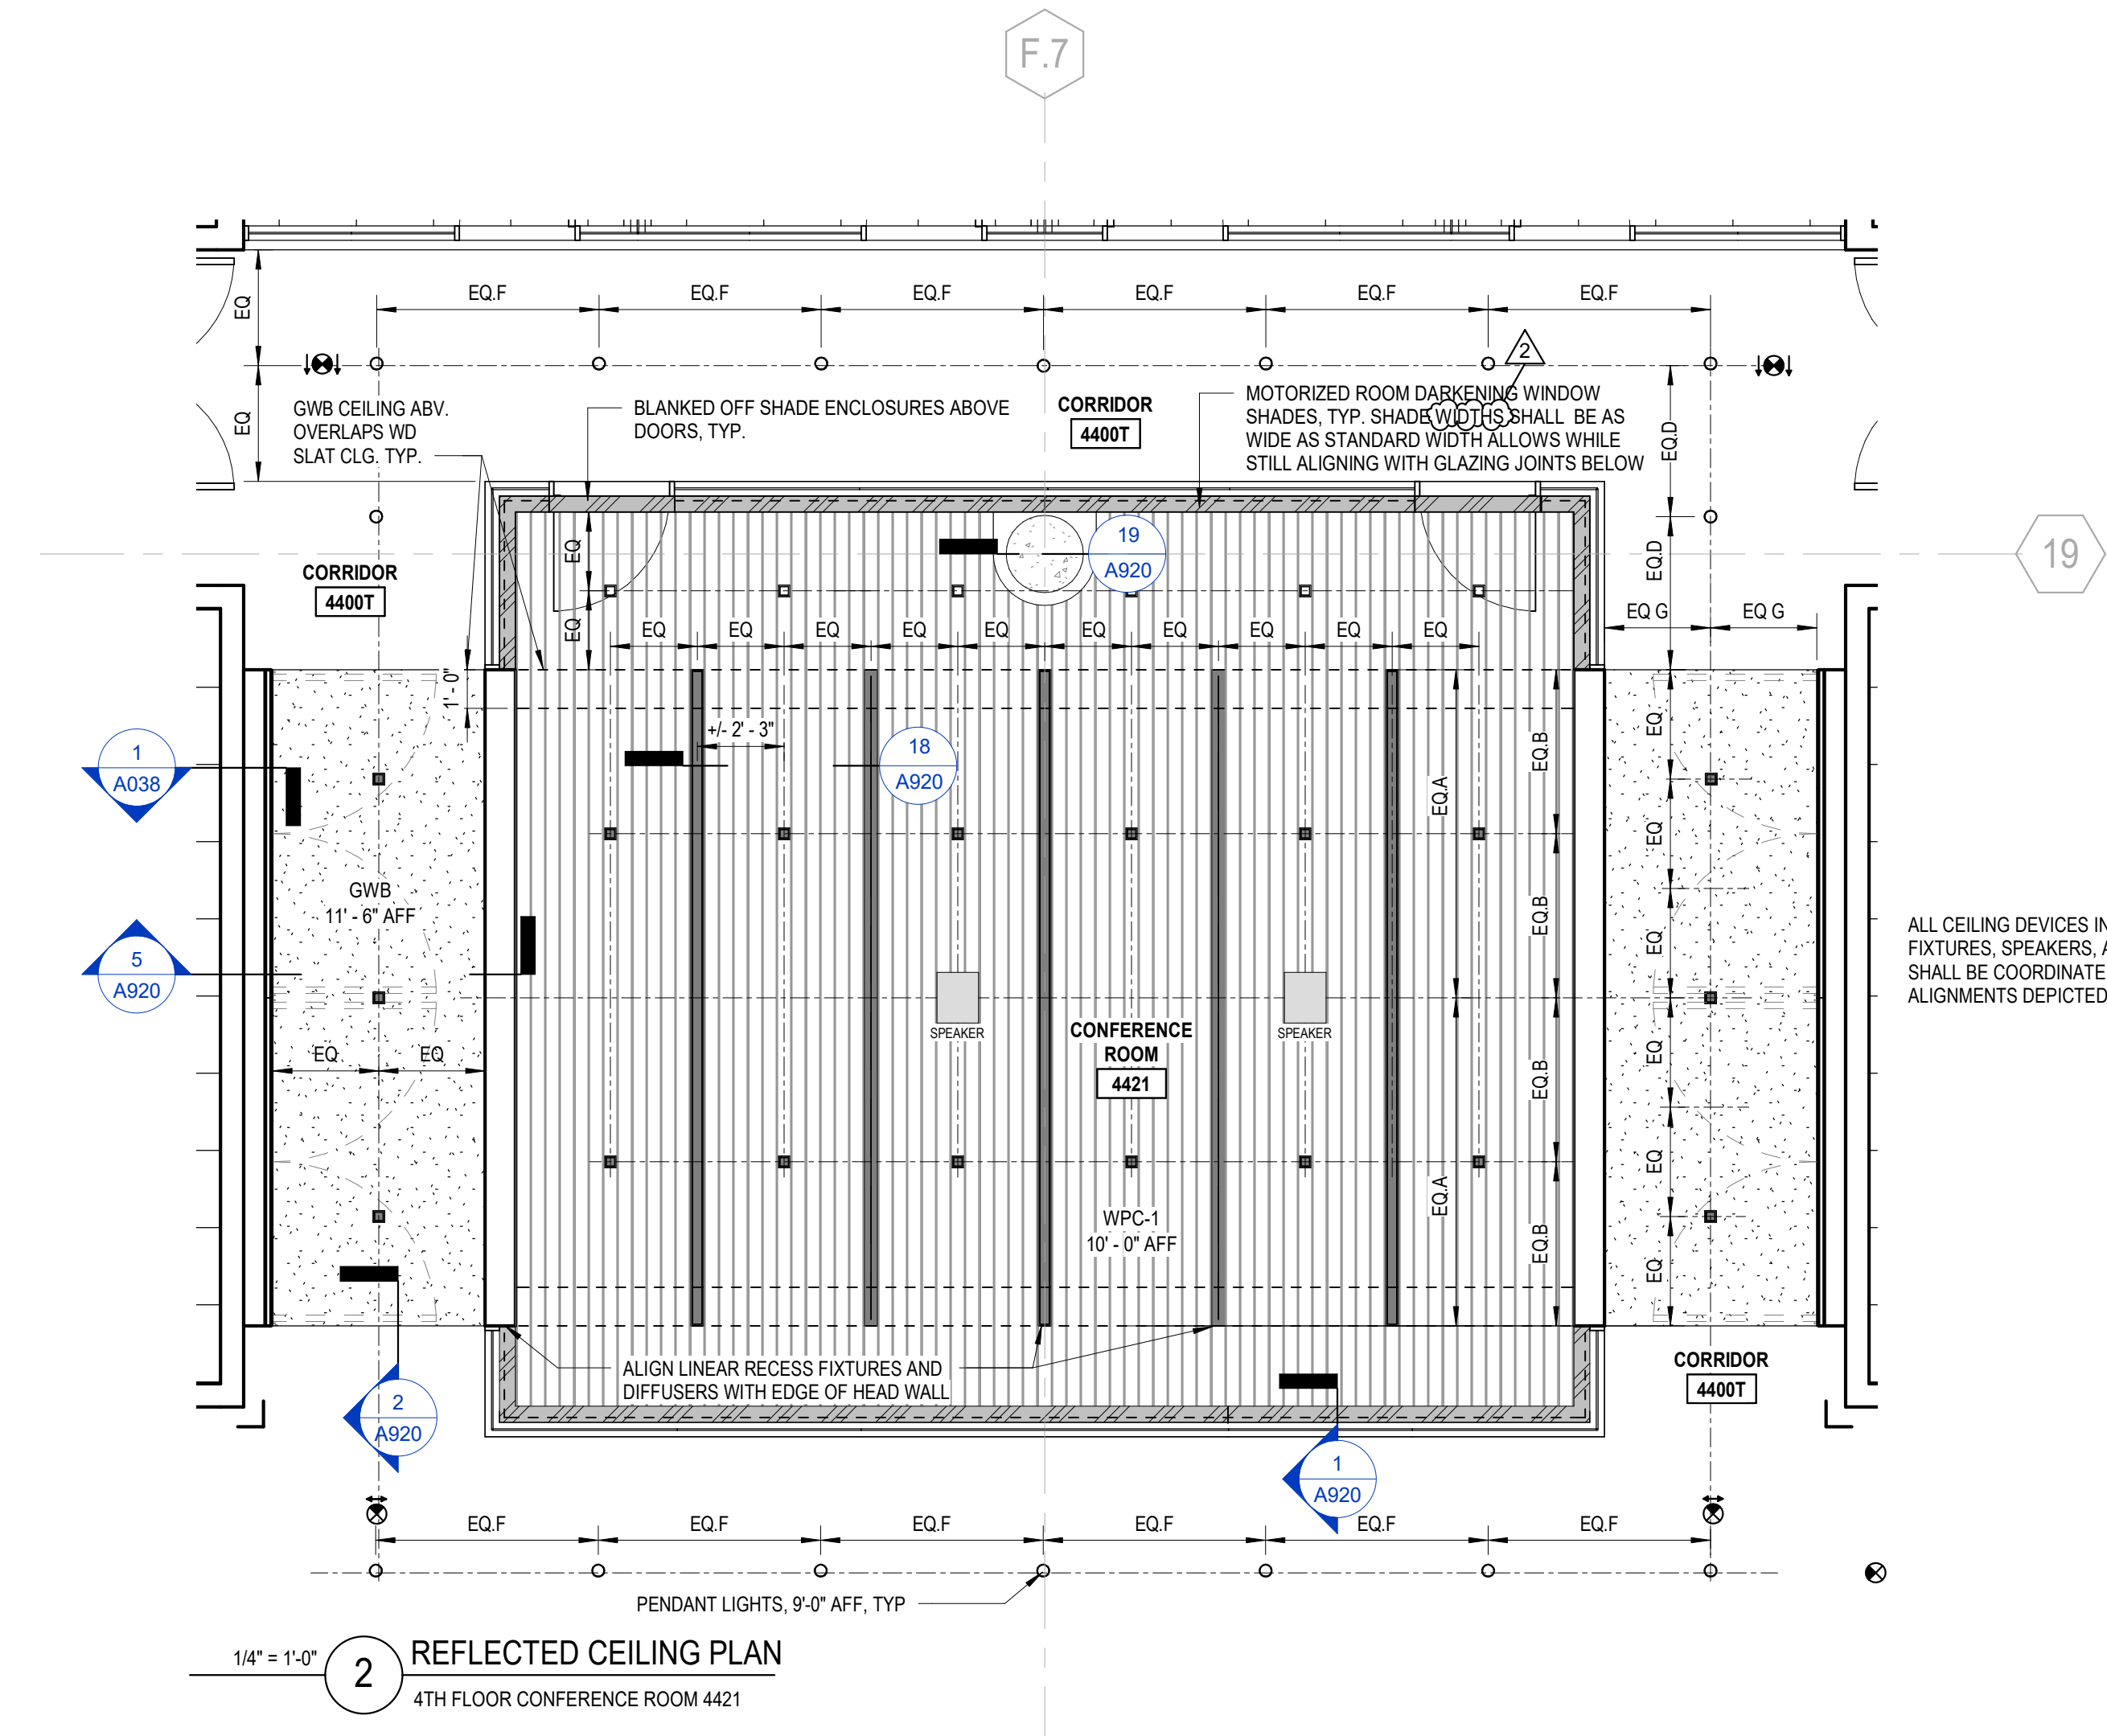

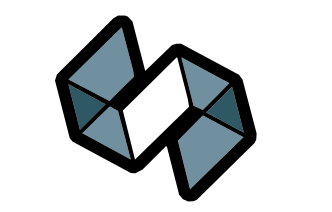

STRANG


ARCHITECTURE
ENGINEERING
INTERIOR DESIGN

811 East Washington Ave, Suite 200
Madison, WI 53703
761.226.9500

Consultant:


ballinger

833 Chestnut Street / Suite 1400
Philadelphia, PA 19107
215.466.8000 /
1-800-441-1111
ballinger.com

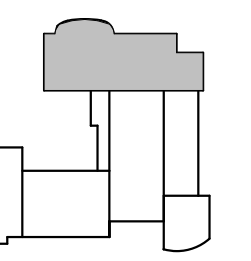

KEY PLAN

The Board of Regents of the
University of Wisconsin on behalf of
the University of Wisconsin - Madison

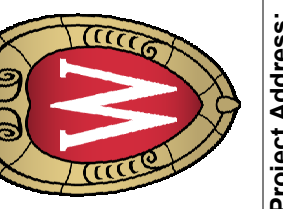


Project Address:

Project Title:
**CHEMISTRY 2ND AND 4TH FLOOR LAB
RENOVATION**
Agency / Institution:
UNIVERSITY OF WISCONSIN-MADISON


Sheet Title:
INTERIOR ELEVATIONS

Revisions		
No.	Date	Description
2	9/19/2023	ADDENDUM NO. 2


Graphic Scale	VARIABLES
UWAS#	A-22-015
Set Type	BD
Date Issued	09/19/2023
Sheet Number	A715

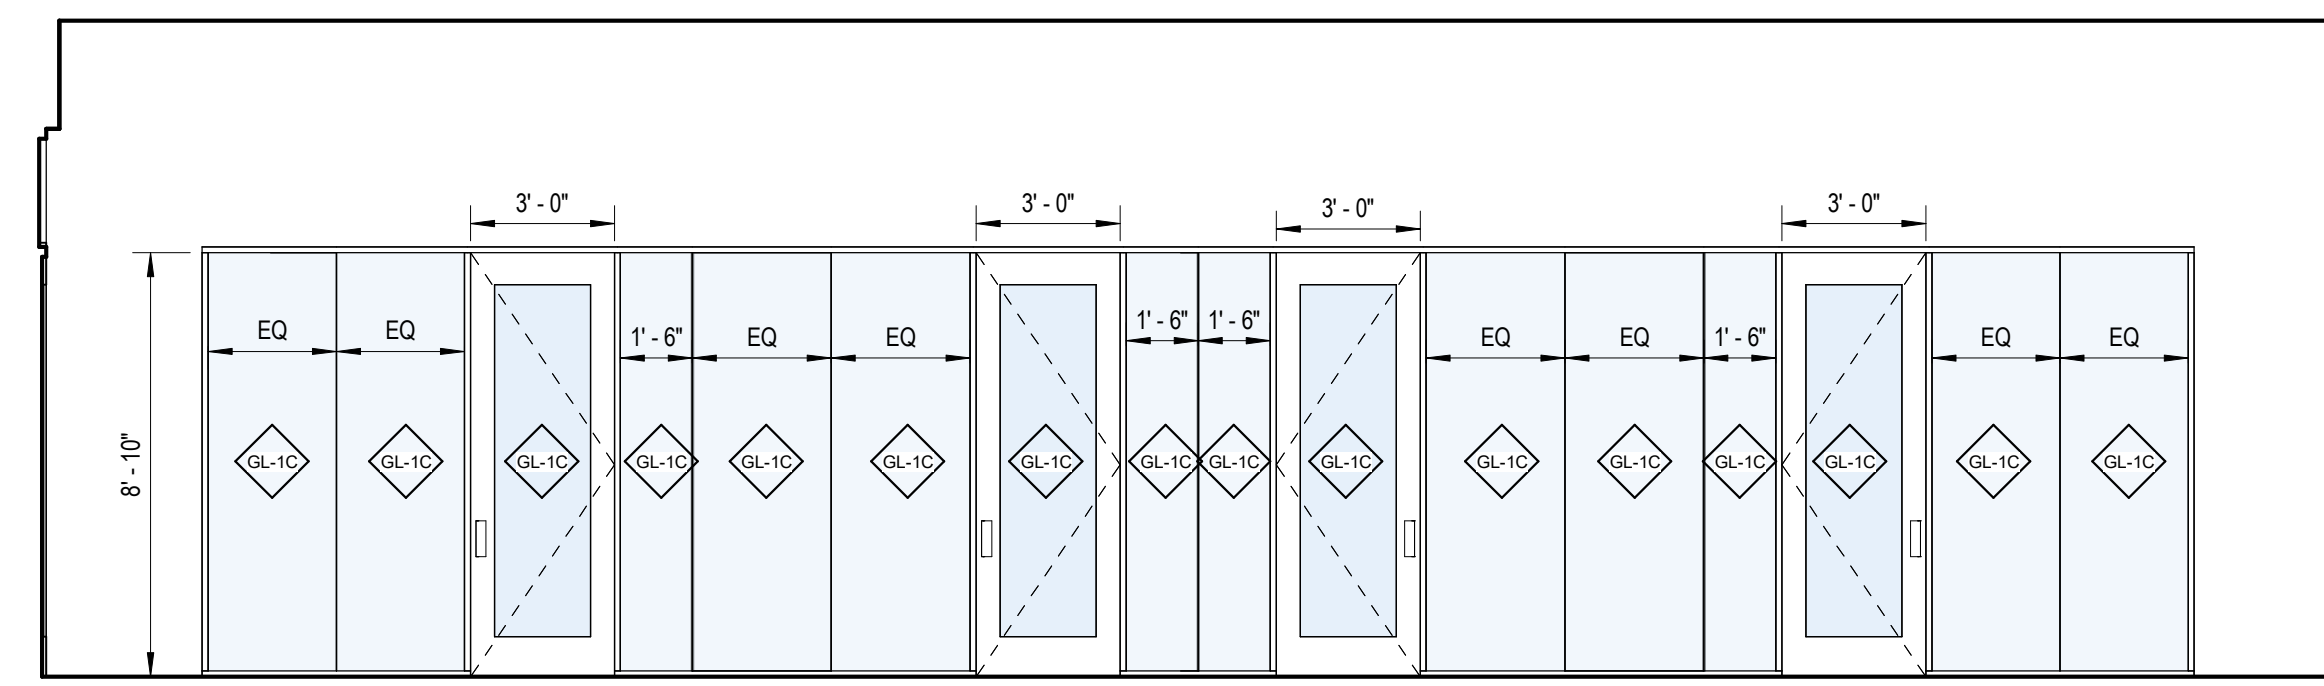


9 Corridor 4400T - North
SCALE: 1/4" = 1'-0"

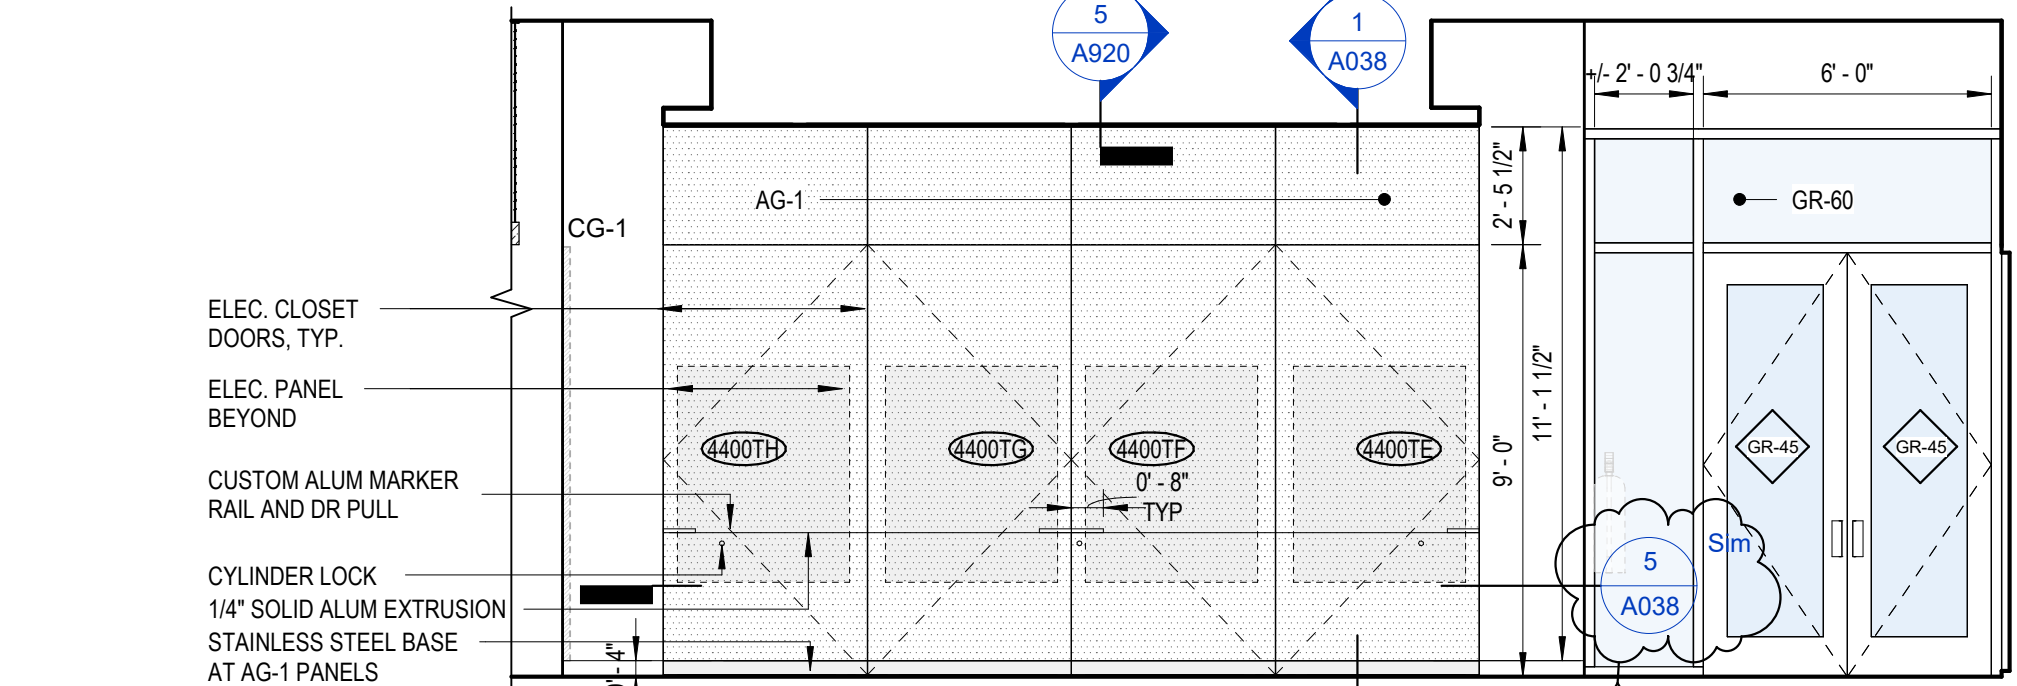


8 Corridor 4400T - West
SCALE: 1/4" = 1'-0"

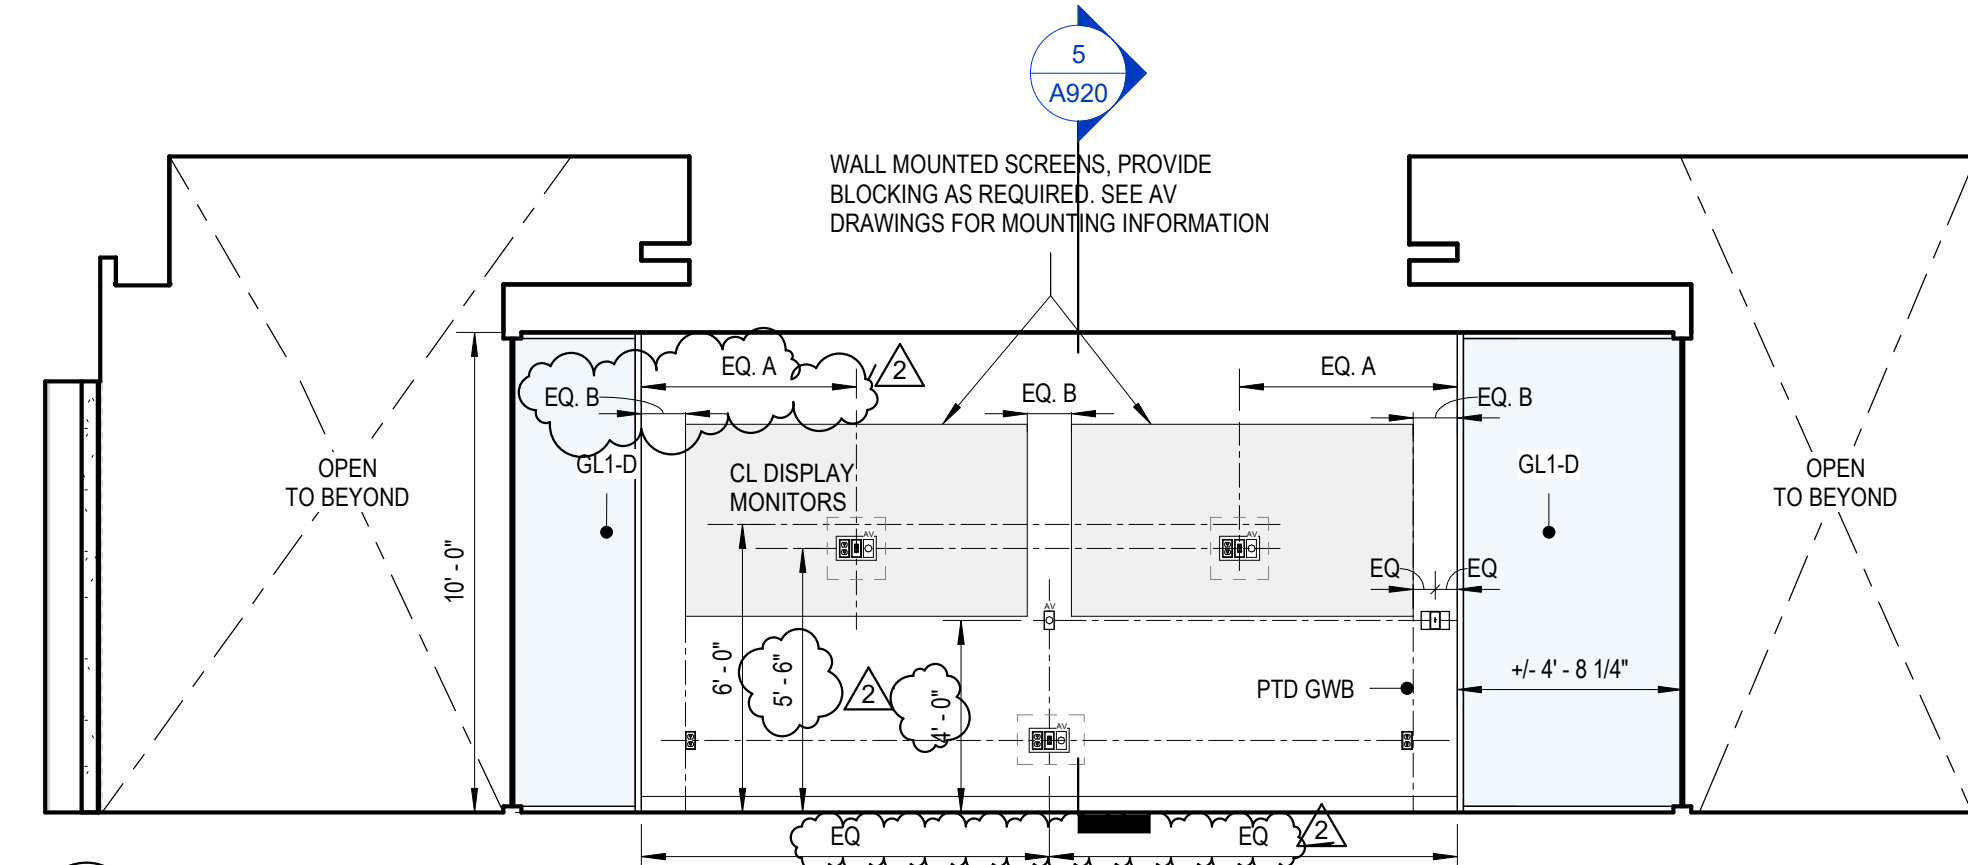


7 Conference Room 4421 - West
SCALE: 1/4" = 1'-0"

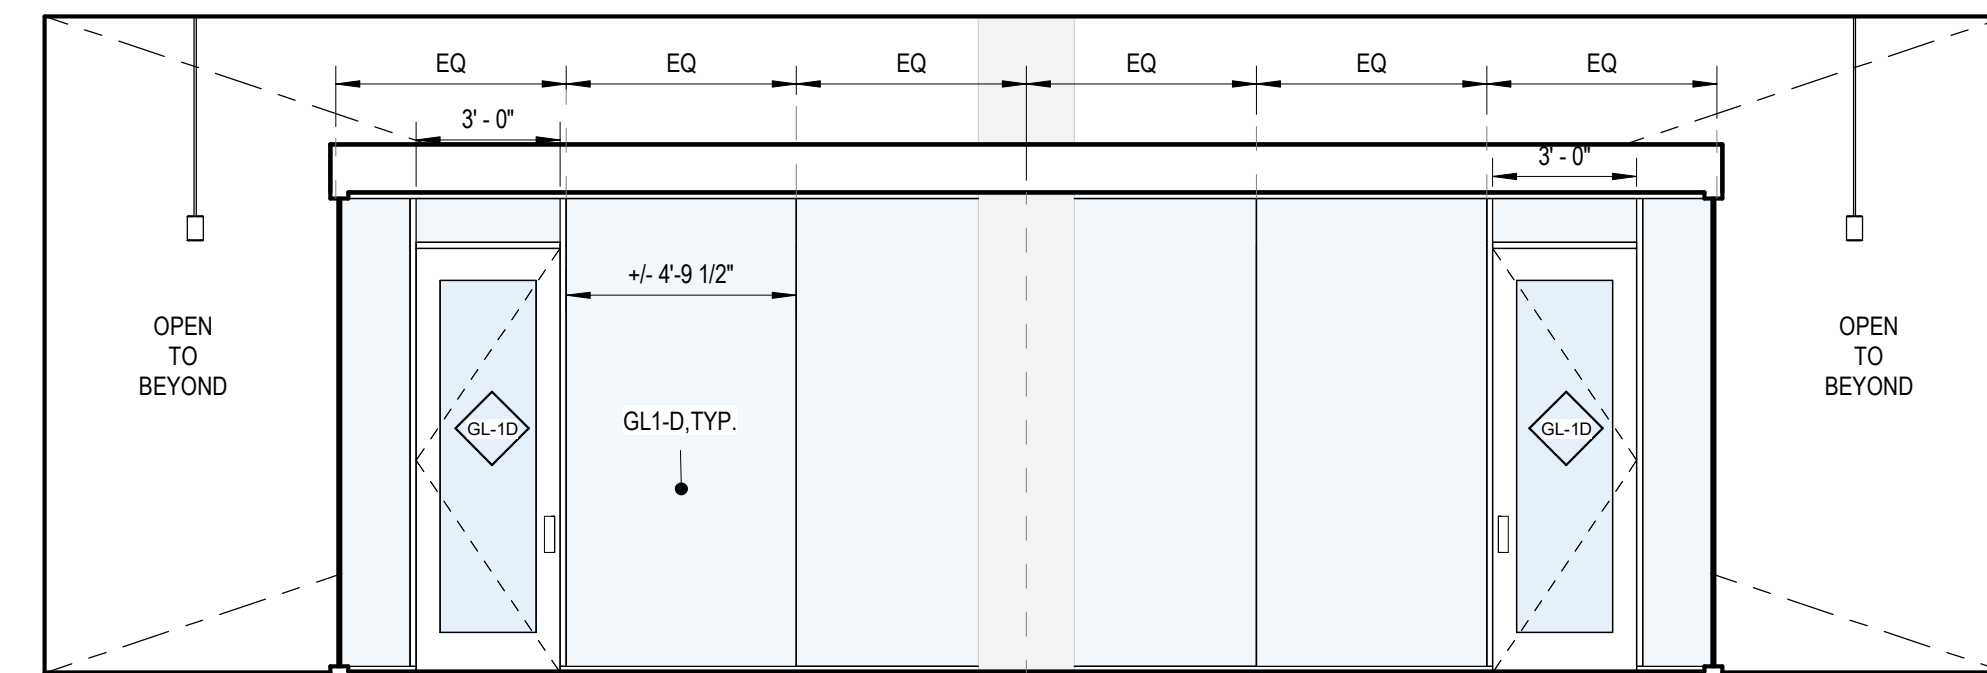


6 Conference Room 4421 - North
SCALE: 1/4" = 1'-0"

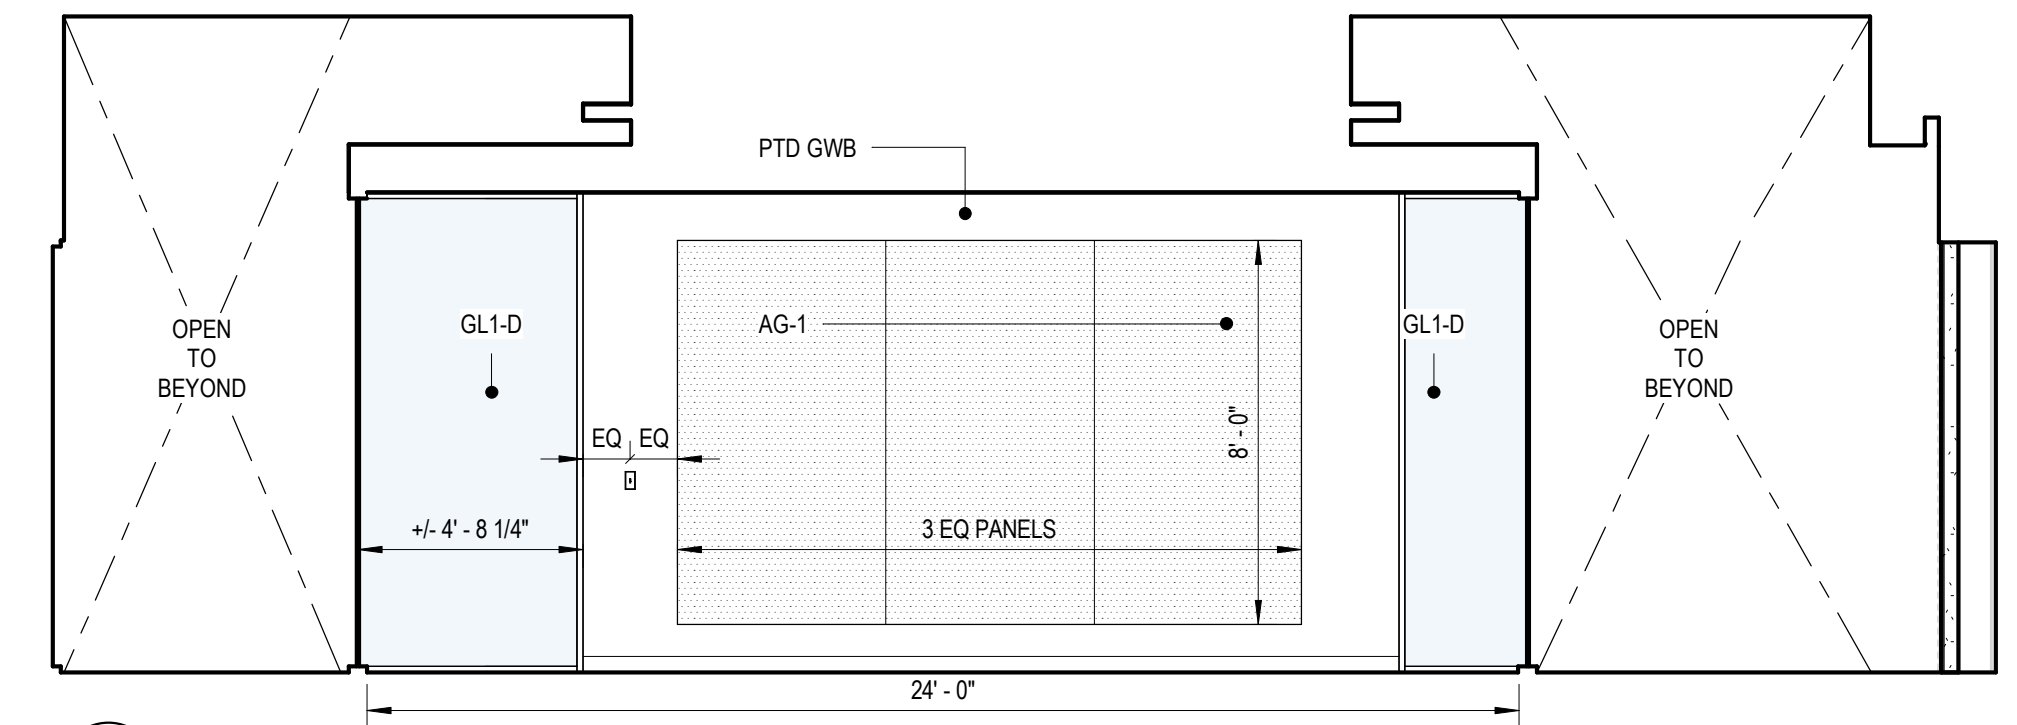

5 Conference Room 4421 - East
SCALE: 1/4" = 1'-0"

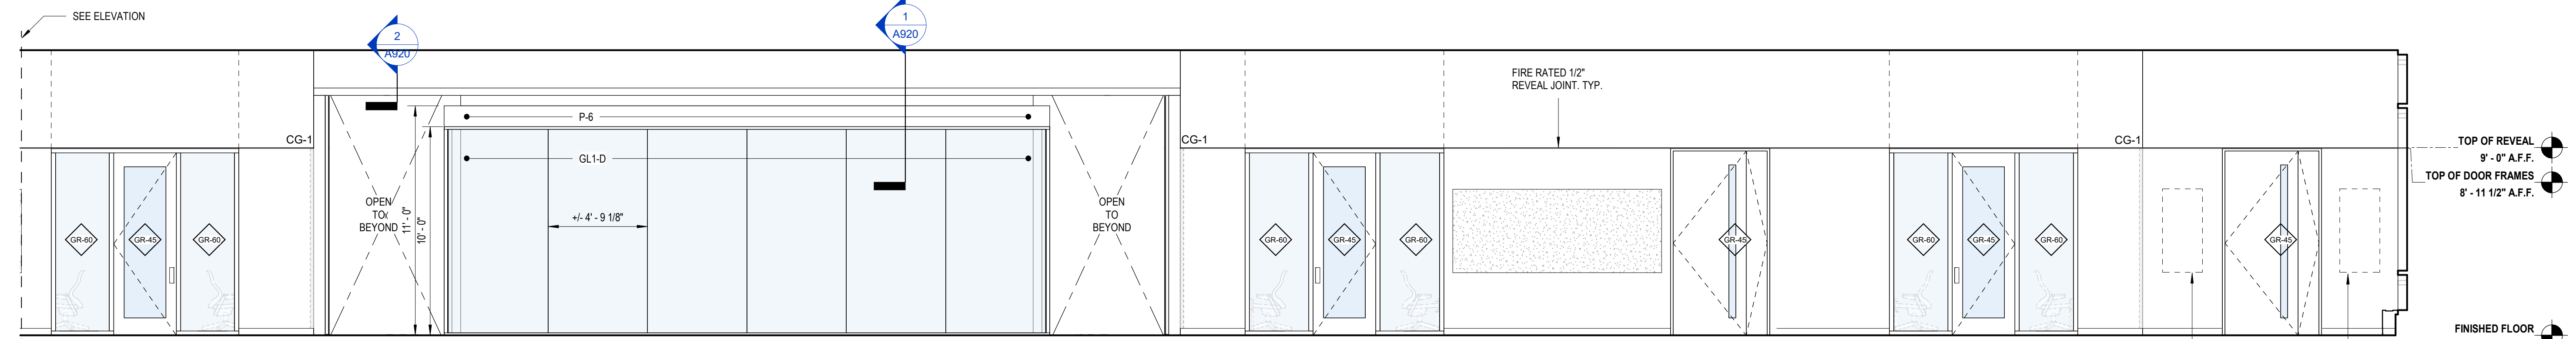


4 Corridor 4400M/L - North
SCALE: 1/4" = 1'-0"

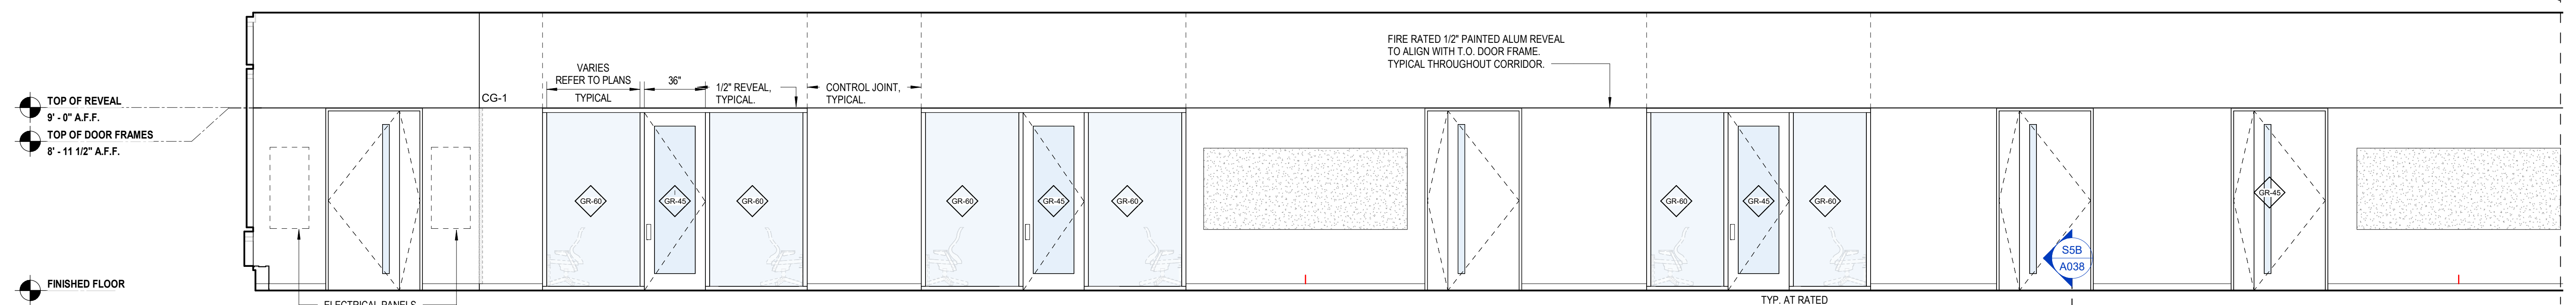


3 Corridor 4400N - North
SCALE: 1/4" = 1'-0"



2 Corridor 4400N - South
SCALE: 1/4" = 1'-0"

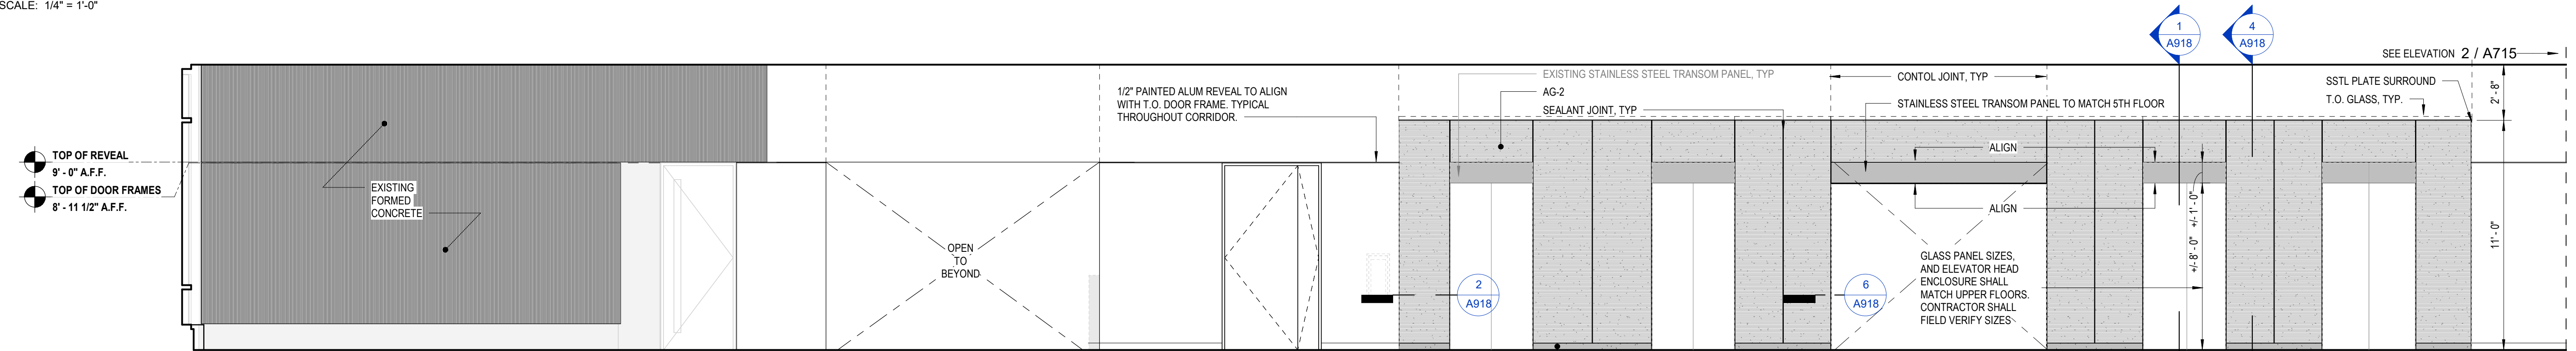

1 Corridor 4400M/L - South
SCALE: 1/4" = 1'-0"

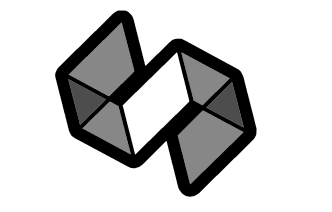

STRANG

ARCHITECTURE
ENGINEERING
INTERIOR DESIGN

811 EAST WASHINGTON
AVE
MADISON, WI 53703
T/ 608 276 9200


Consultant:



Affiliated Engineers, Inc.
5802 Research Park Boulevard
Madison, Wisconsin 53719
Tel 608.236.2616 Fax 608.238.2614

KEY PLAN

The Board of Regents of the
University of Wisconsin on behalf of
the University of Wisconsin - Madison

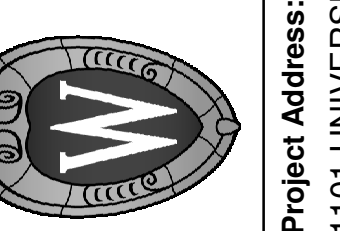


Project Address:
1101 UNIVERSITY AVENUE
MADISON, WI 53706-1322

Project Title:
**CHEMISTRY 2ND AND 4TH FLOOR LAB
RENOVATION**
Agency/Institution:
UNIVERSITY OF WISCONSIN-MADISON


Revisions		
No.	Date	Description
1	9/19/2023	ADDENDUM #2

Graphic Scale	
UWS#	A-22-015
Set Type	BD
Date Issued	08/24/2023
Sheet Number	E102.5-d

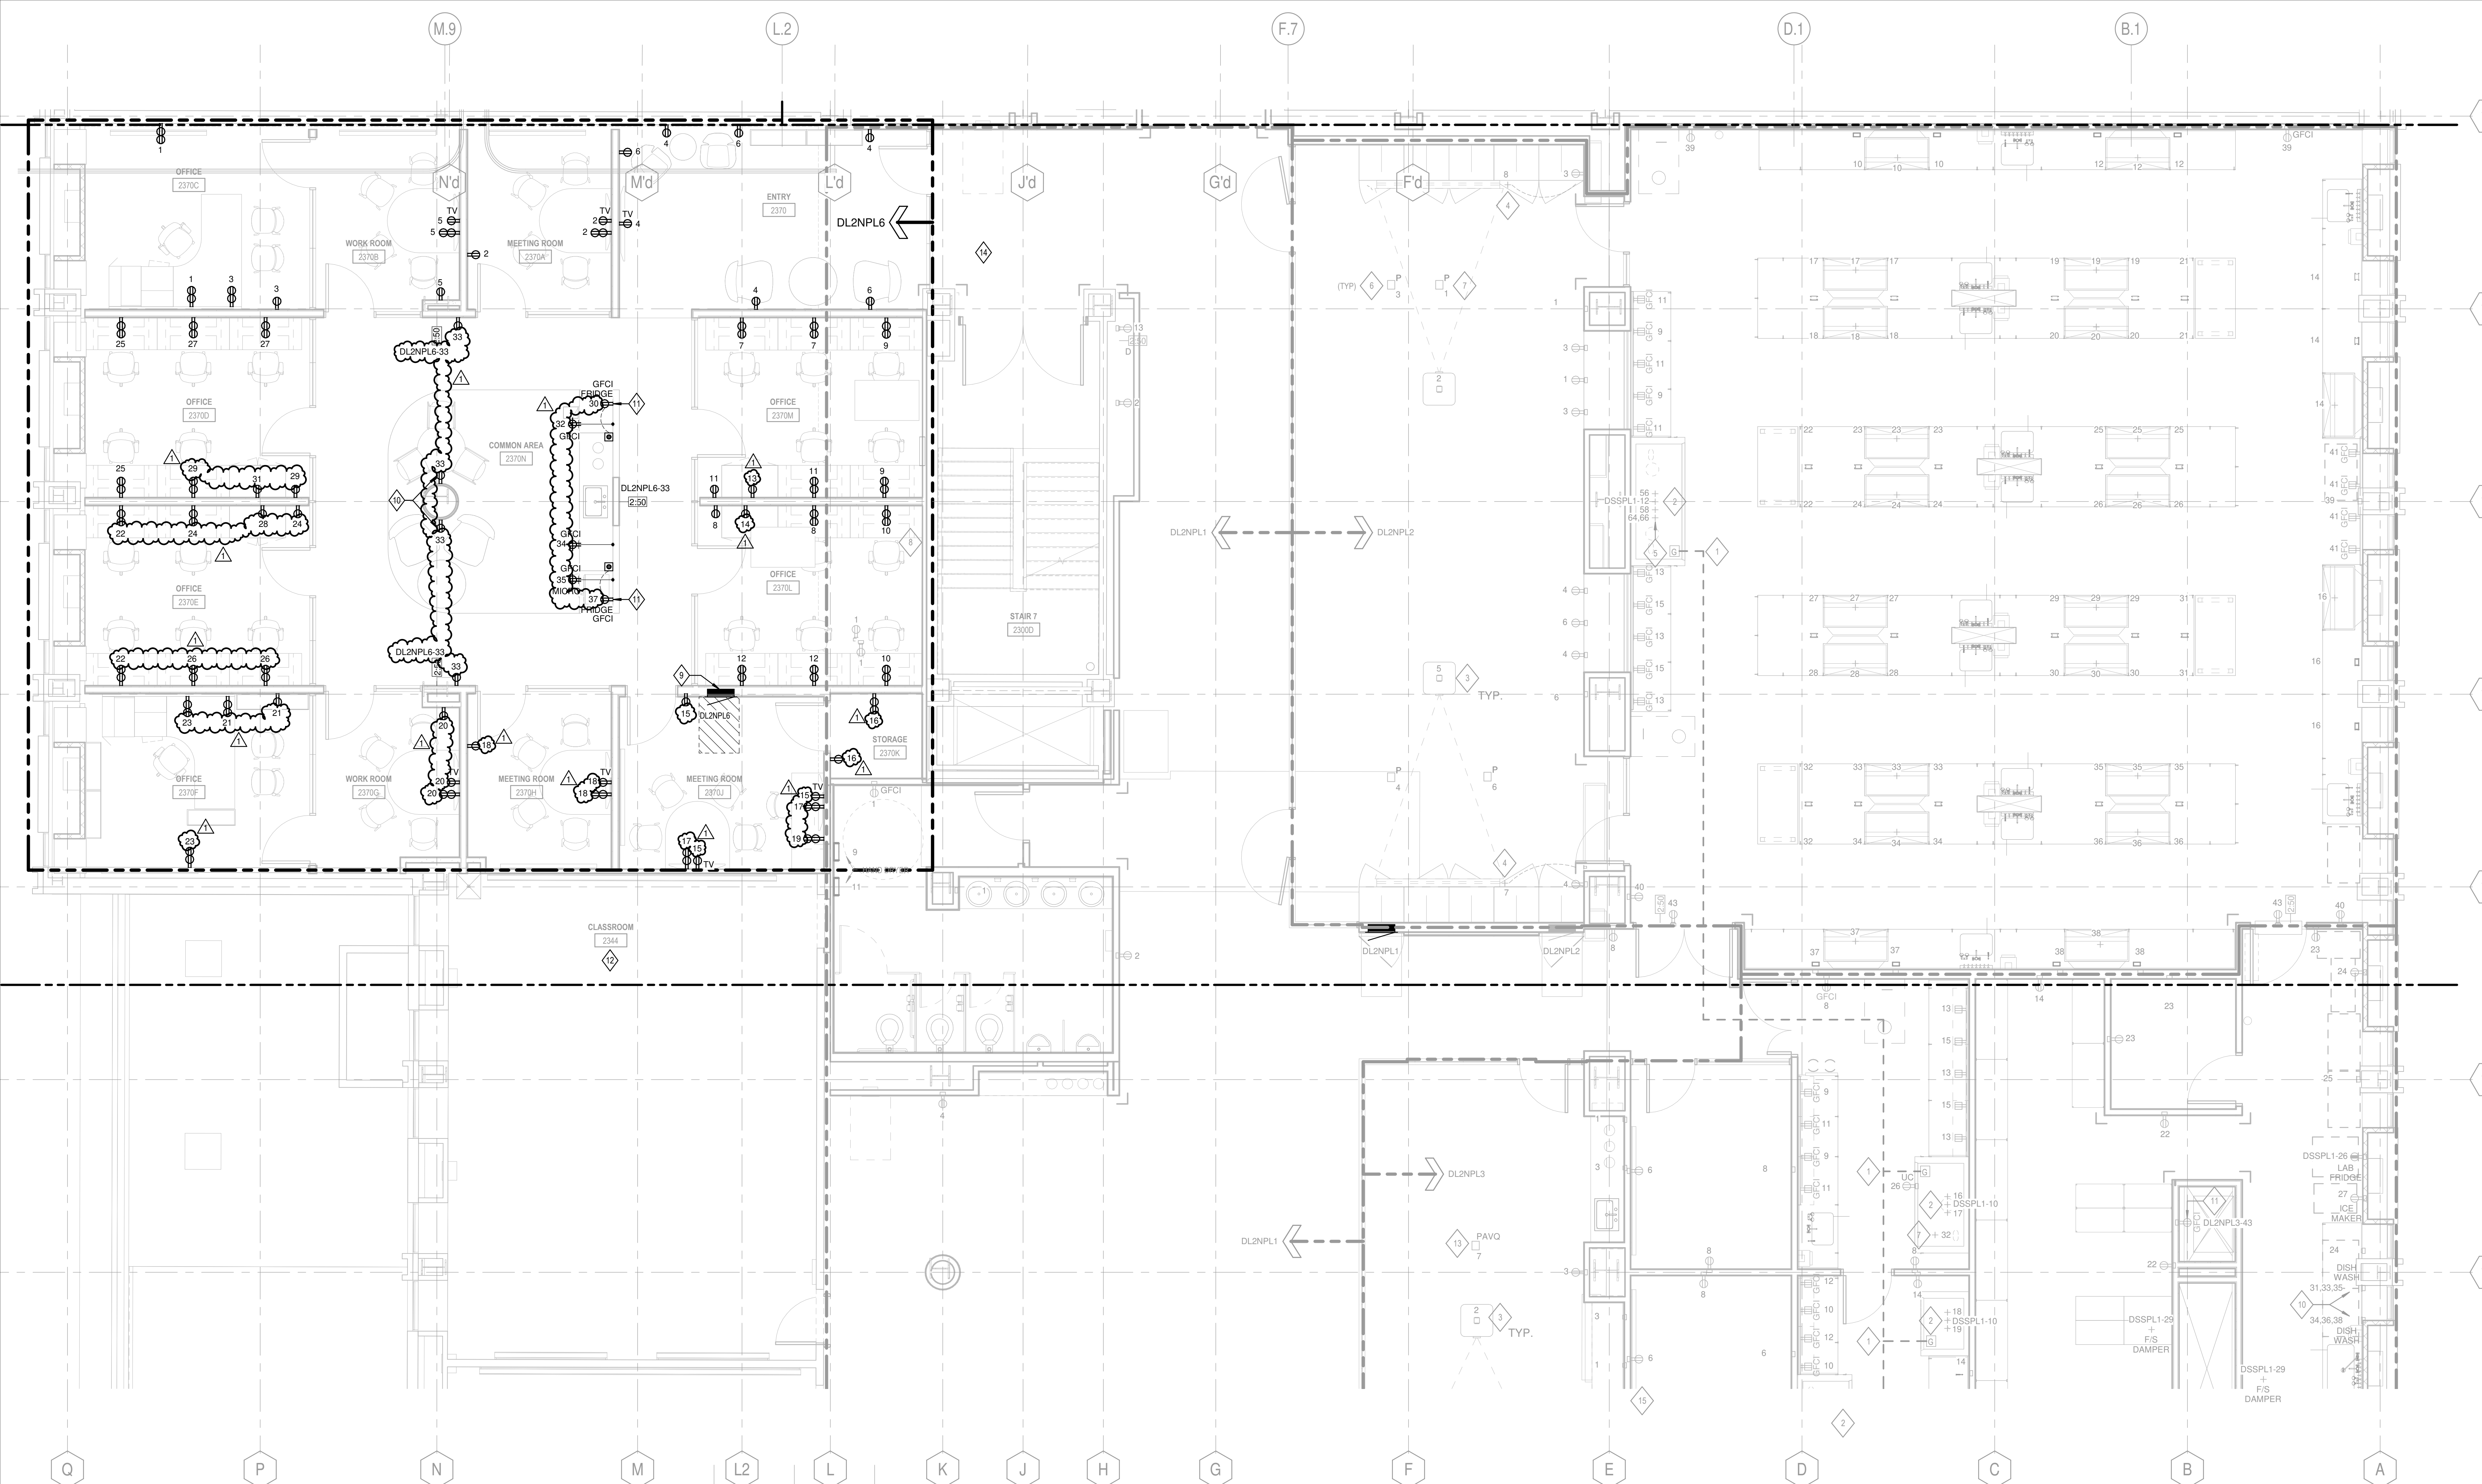

ELECTRICAL POWER PLAN - 2ND FLOOR - DANIELS (NORTH)

SCALE: 1/4" = 1'-0"

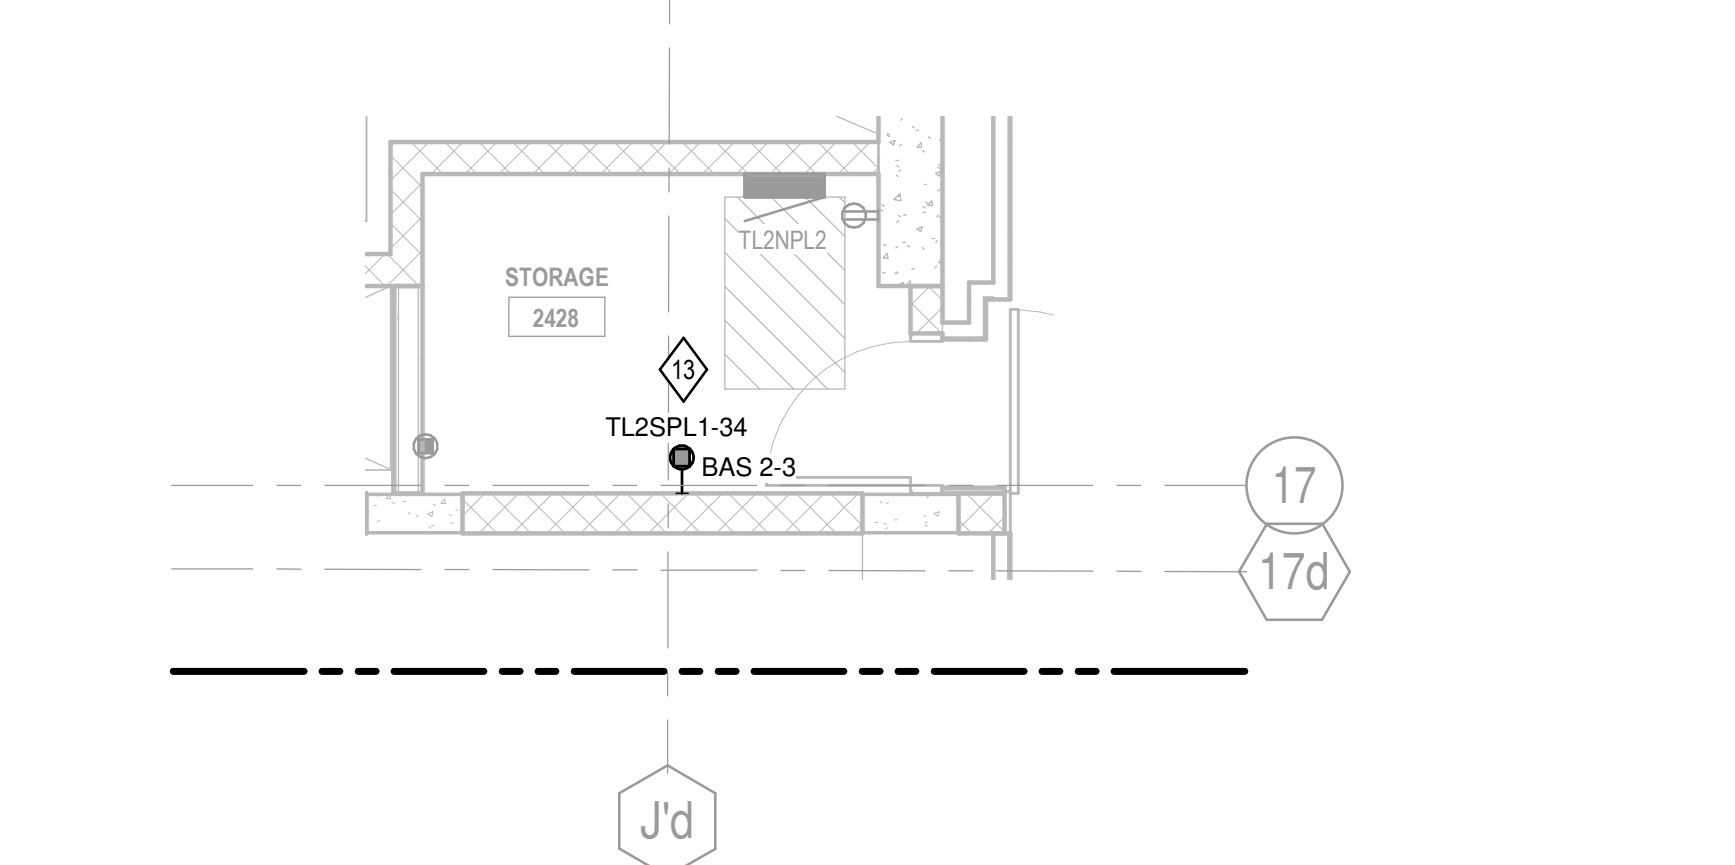


ELECTRICAL POWER PLAN - 2ND FLOOR - TOWER

SCALE: 1/4" = 1'-0"

ELECTRICAL POWER PLAN - 2ND FLOOR - DANIELS (SOUTH)

SCALE: 1/4" = 1'-0"

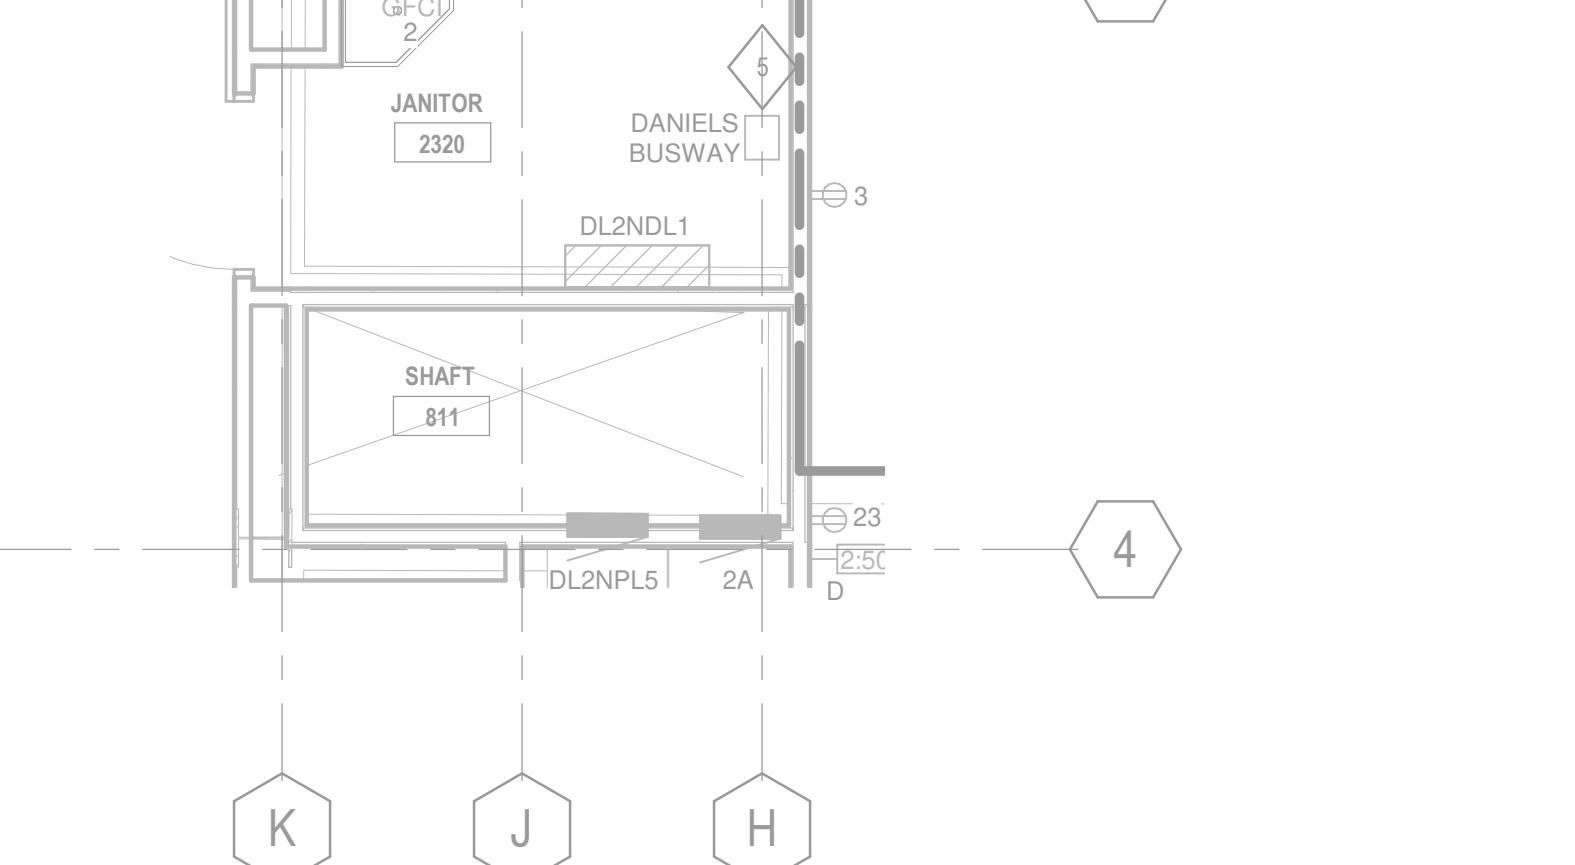

ELECTRICAL POWER PLAN - 2ND FLOOR - DANIELS (SOUTH)

SCALE: 1/4" = 1'-0"


- 9 PROVIDE (6) SPARE 3/4" CONDUITS TO ACCESSIBLE LOCATION ABOVE CEILING FLOOR FOR EACH RECESSED PANELBOARD PER SPECIFICATION SECTION 26 24 16.
- 10 REFER TO ARCHITECTURAL DETAIL 1/A013 FOR ELECTRICAL DEVICE MOUNTED ON COLUMN.
- 11 PROVIDE A 120V, 20A FACELESS GFCI ON WALL. GFCI SHALL BE WIRED IN SERIES TO THE LINE SIDE OF THE DEDICATED APPLIANCE RECEPTACLE CIRCUIT. GFCI SHALL BE PROVIDED WITH LABEL OF FACEPLATE THAT READS "RESET". LABEL SHALL ALSO IDENTIFY APPLIANCE TYPE.
- 12 RECURT EXISTING PANEL 28 ELECTRICAL CIRCUITS IN THIS ROOM. PANEL 28 LIGHTING CIRCUITS 1, 2, 3, RECEPTACLE CIRCUITS 7 & 8 AND CEILING RECEPTACLE CIRCUIT 9 SHALL BE REFEED FROM PANEL DL2NPL1. PROVIDE (6) 20A BREAKERS, CONDUIT, AND CONDUCTORS TO EXISTING DEVICES.
- 13 PROVIDE 120V, 20A FIXED EQUIPMENT LOCATION FOR TEMPERATURE CONTROL PANEL. COORDINATE EXACT LOCATION WITH TIC VENDOR PRIOR TO ROUGH-IN. PANEL TL2SPL1 IS LOCATED IN ELECTRICAL ROOM 2430B ON THIS FLOOR.
- 14 RECURT EXISTING PANEL 28 ELECTRICAL CIRCUITS ON THIS FLOOR. PANEL 28 STARWELL PLUG CIRCUIT 17 AND HALLWAY RECEPTABLES CIRCUIT 23 SHALL BE REFEED FROM PANEL DL2NPL1. PROVIDE (1) 20A AND (1) 20A BREAKERS, CONDUIT, AND CONDUCTORS TO EXISTING DEVICES.

SHEET KEYNOTES

- 1 TYPICAL: ALL FUME HOODS AND FLAMMABLE STORAGE CABINETS SHALL BE GROUNDED. THE INSULATED GROUNDING WIRE SHALL BE #6 AWG AND SHALL BE BONDED TO LAB GROUNDING LOOP (#2 AWG) WITH IRREVERSIBLE COMPRESSION FITTING. THE LAB GROUNDING LOOP SHALL BE BONDED TO THE GROUNDING BAR IN THE ELECTRICAL ROOM. MOUNT GROUND LOOP SO THAT IT IS OUT OF VIEW FROM FLOOR.
- 2 PROVIDE (2) NORMAL AND (1) STANDBY POWER CONNECTIONS TO FUME HOOD.
- 3 CEILING MOUNTED DUPLEX RECEPTABLES DEDICATED FOR PROJECTOR.
- 4 PROVIDE 120V, 20A CONNECTION AND SWITCH FOR AUTOMATIC PROJECTOR SCREEN.
- 5 PROVIDE 208V CIRCUIT FOR NEMA 6-15R ON EXISTING FUME HOOD. CONTRACTOR TO CONFIRM METHOD OF CONNECTING TO RECEPTACLE WITH EXISTING EQUIPMENT CONFIGURATION.
- 6 PROVIDE POWER ONLY POKE THROUGH WIREMOLD RGSA15TCAL OR EQUAL.
- 7 LOCATE POKE THROUGH TO AVOID DUCTWORK BELOW.
- 8 PROVIDE INFILL AND PATCHING OF DEMOLISHED CLASS BELL AND FIRE ALARM BOXES TO MATCH REQUIRED FIRE RATING OF WALL.

GENERAL NOTES

- 1. REFER TO DRAWING E001 FOR SYMBOLS AND ABBREVIATIONS.
- 2. ALL RECEPTABLES LOCATED WITHIN 6 FEET OF SINKS SHALL BE PROVIDED WITH INTEGRAL GROUND FAULT INTERRUPTER WHETHER SHOWN ON PLANS OR NOT.
- 3. REFER TO M-SERIES AND P-SERIES DRAWINGS FOR EXACT MOTOR LOCATIONS.
- 4. REFER TO ARCHITECTURAL PLANS, DETAILS AND ELEVATIONS FOR LOCATIONS, MOUNTING HEIGHTS, AND FINISHES OF ELECTRICAL DEVICES.

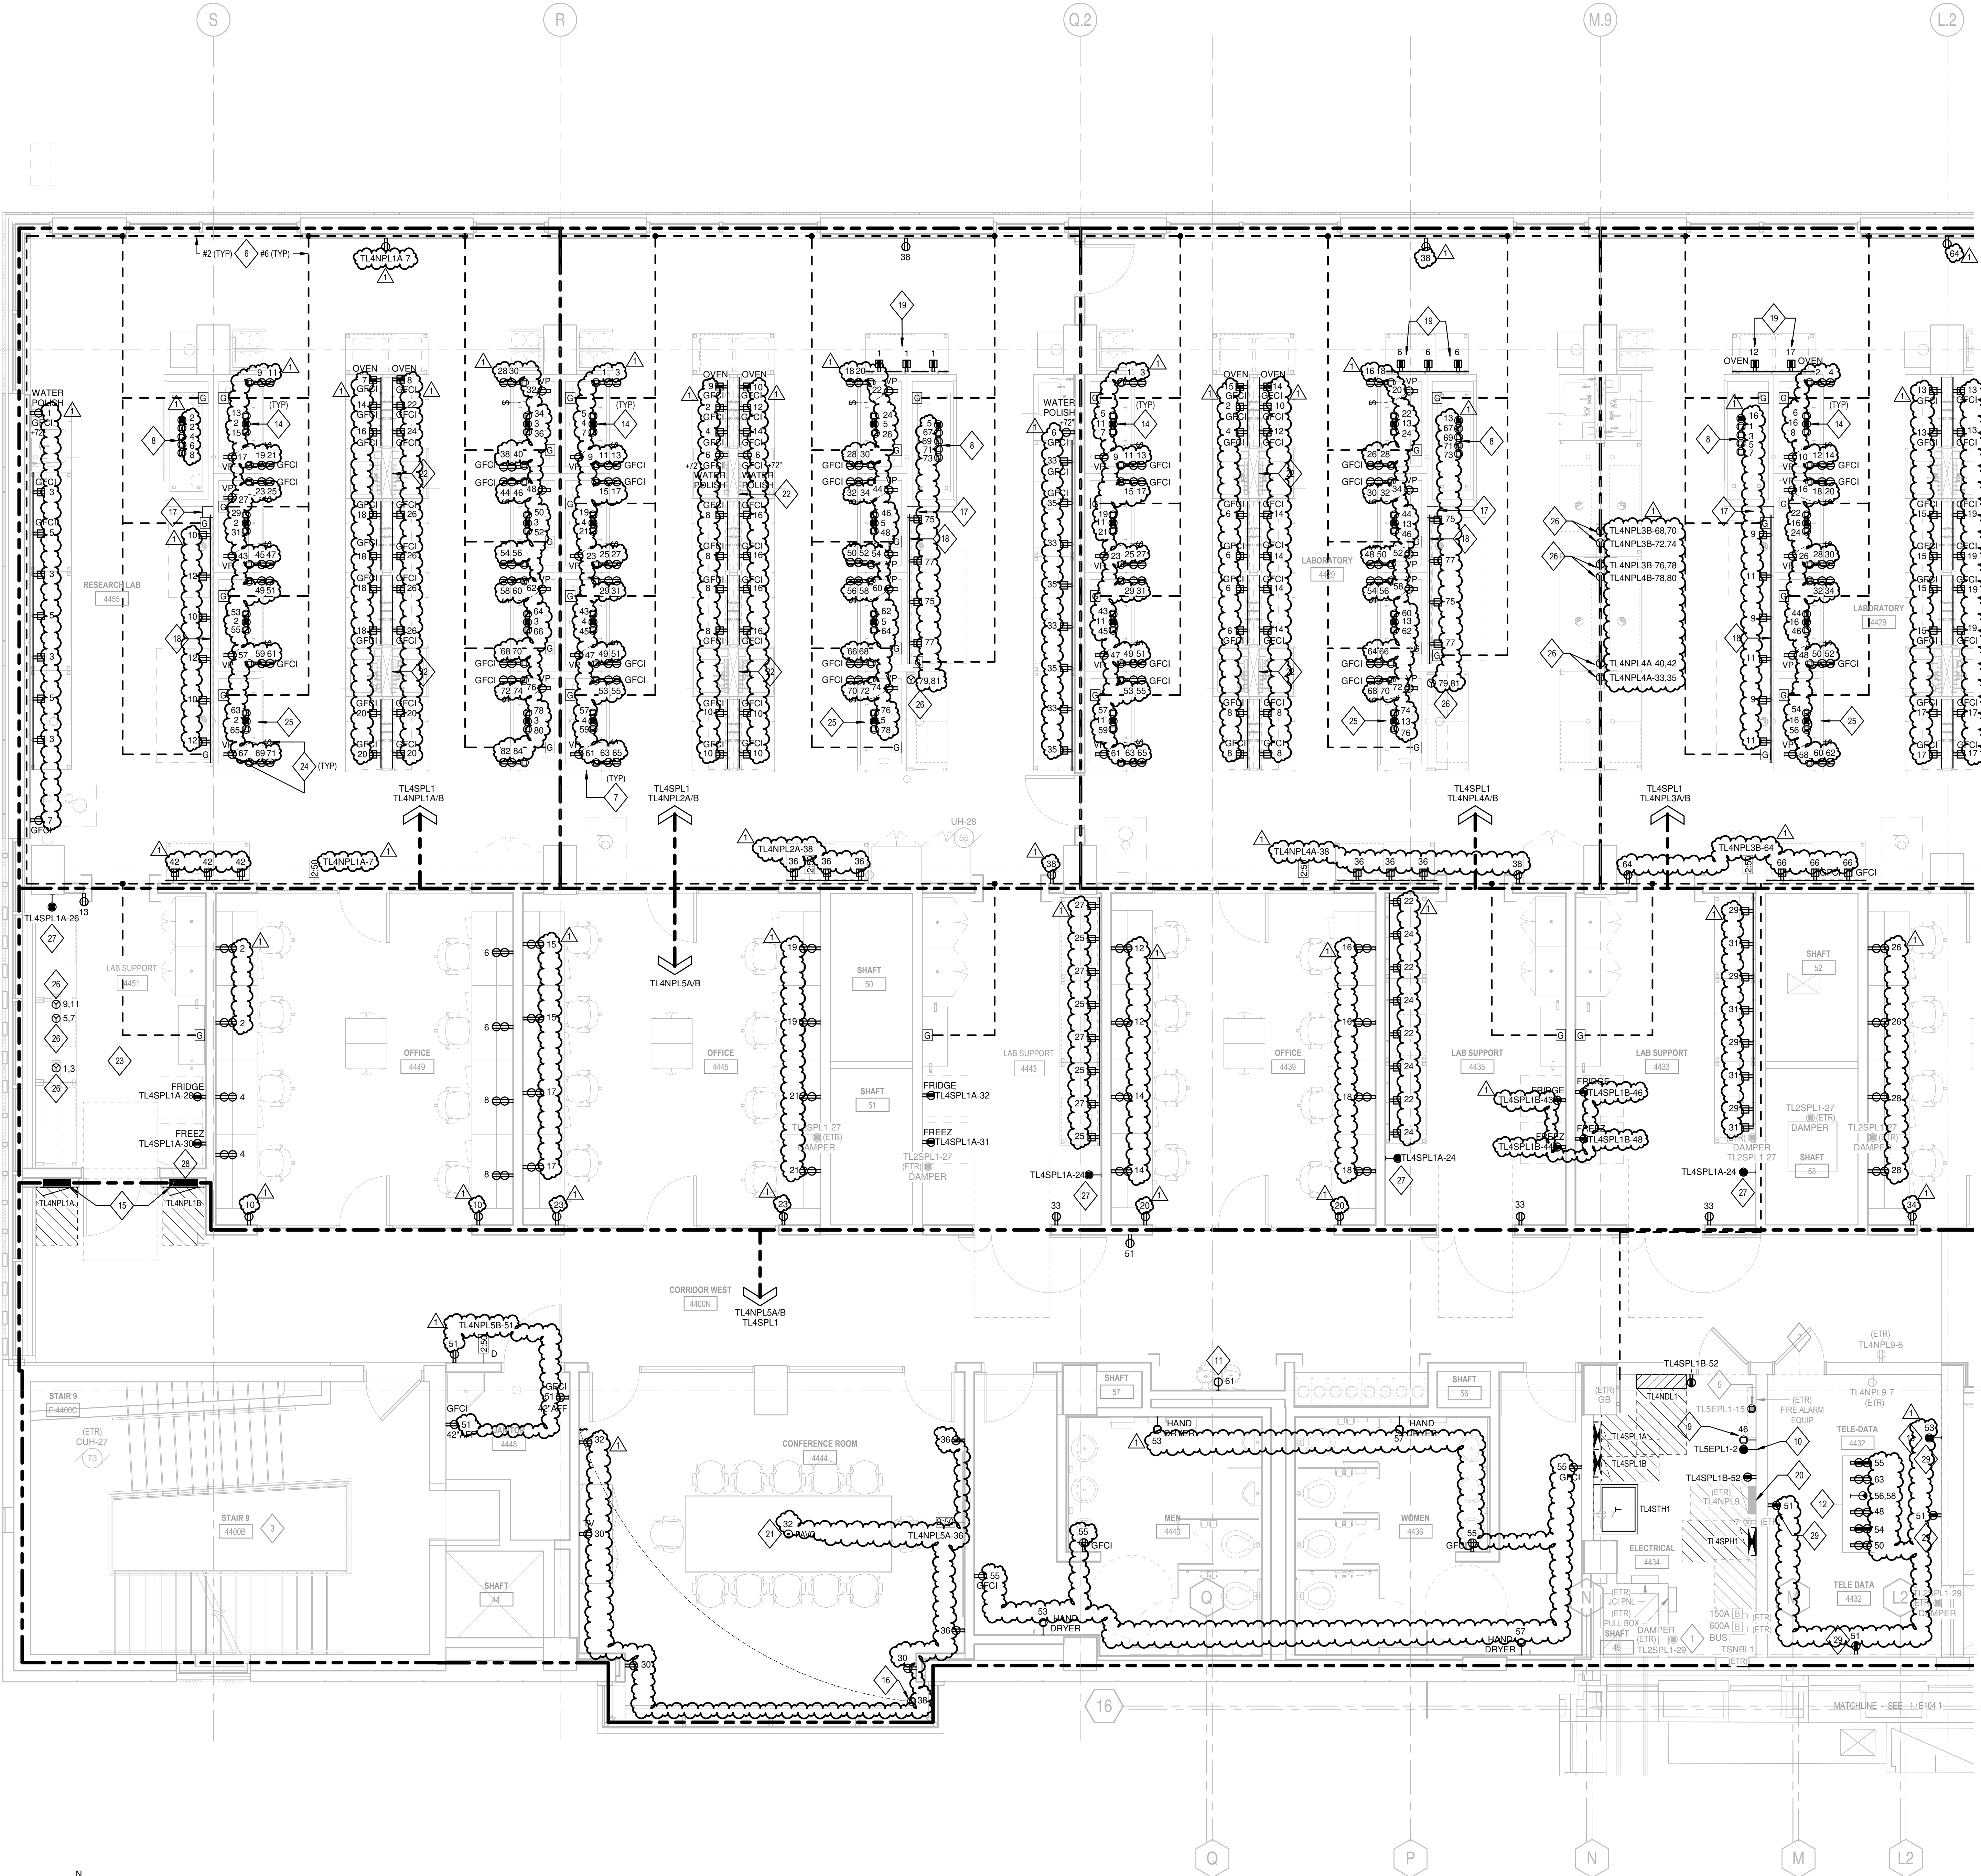

ELECTRICAL POWER PLAN - 4TH (WEST)
 SCALE: 1/4" = 1'-0"

GENERAL NOTES

- REFER TO DRAWING E001 FOR SYMBOLS AND ABBREVIATIONS.
- REFER TO M-SERIES AND P-SERIES DRAWINGS FOR EXACT MOTOR LOCATIONS.
- REFER TO ARCHITECTURAL PLANS, DETAILS AND ELEVATIONS FOR LOCATIONS, MOUNTING HEIGHTS, AND FINISHES OF ELECTRICAL DEVICES.
- REFER TO E708 ELECTRICAL GROUNDING RISER FOR INFORMATION ON GROUNDING CONNECTIONS. ELECTRICAL GROUNDING SHALL NOT BE CONNECTED TO AV/TELECOM GROUND BAR.
- EXPOSED CONDUITS IN PUBLIC AND USER SPACES SHALL BE MINIMUM 12'-0" ABOVE FINISHED FLOOR.


SHEET KEYNOTES

- PROVIDE PLUG-IN CIRCUIT BREAKER TO FEED FUTURE NORMAL POWER EQUIPMENT.
- ELECTRICAL ROOMS IN SHELL FLOORS ARE FITOUT WITH EQUIPMENT DURING CORE PROJECT PHASE. REFER TO E601 ENLARGED ELECTRICAL ROOM FLOOR PLAN FOR MORE INFORMATION.
- CONDUIT AND BACKBOX MOUNTED IN STAIR SHALL BE RECESSED. PROVIDE 1" CONDUIT TO FACILITATE INSTALLATION OF FUTURE SERVICES. SURFACE MOUNTED BACKBOX AND CONDUIT NOT PERMITTED.
- NOT USED.
- PROVIDE POWER TO FIRE ALARM POWER SUPPLIES FROM PANEL TL4SPL1. CIRCUIT 15. COORDINATE EXACT LOCATION WITH FIRE ALARM CONTRACTOR.
- TYPICAL: ALL FUME HOODS AND FLAMMABLE STORAGE CABINETS SHALL BE GROUNDED. THE INSULATED GROUNDING WIRE SHALL BE #6 AWG AND SHALL BE BONDED TO LAB GROUNDING LOOP (#2 AWG) WITH IRREVERSIBLE COMPRESSION FITTING. THE LAB GROUNDING LOOP SHALL BE BONDED TO THE GROUNDING BAR IN THE ELECTRICAL JUNCTION BOX GROUNDING LOOP SO THAT IT IS OUT OF VIEW FROM FLOOR. REVIEW AND MATCH EXISTING LABS ON UPPER FLOORS OF TOWER.
- REFER TO DETAIL 1 ON SHEET L602A FOR ADDITIONAL FUME HOOD INFORMATION.
- FLOOR MOUNTED FUME HOODS:
 - (1) STANDBY FIXED EQUIPMENT CONNECTION SHALL SERVE THE LOW FLOW ALARM.
 - (1) NORMAL FIXED EQUIPMENT CONNECTION SHALL SERVE HOOD LIGHTS AND LEFT SIDE RECEPTACLE.
 - (3) NORMAL FIXED EQUIPMENT CONNECTIONS SHALL SERVE DEDICATED CIRCUIT PREWIRED HOOD CONVENIENCE RECEPTACLES. RECEPTACLES SHALL BE FURNISHED WITH PREWIRED MC CABLE WHIPS BY CASEWORK SUPPLIER. EC SHALL INSTALL MC CABLE WHIPS TO TOP OF FUME HOOD AND CONNECT TO JUNCTION BOX AT TOP OF FUME HOOD.
- PROVIDE 120V, 20A FIXED EQUIPMENT CONNECTION FOR LIGHTING CONTROLS.
- PROVIDE 120V, 20A FIXED EQUIPMENT CONNECTION FOR LIGHTING EQUIPMENT.
- PROVIDE 120V, 20A SIMPLEX RECEPTACLE TO WATER COOLER. CIRCUIT SHALL BE PROTECTED BY GFI BREAKER AT PANEL.
- PROVIDE POWER TO EXISTING RECEPTACLES AT EACH TELECOM EQUIPMENT RACK. REFER TO DETAIL 3401 FOR TYPICAL INSTALLATION DETAIL.
- PROVIDE 120V, 20A STANDBY POWER SECURITY CONTROL PANELS.
- STANDARD FUME HOODS:
 - (1) STANDBY FIXED EQUIPMENT CONNECTION SHALL SERVE THE LOW FLOW ALARM.
 - (1) NORMAL FIXED EQUIPMENT CONNECTION SHALL SERVE HOOD LIGHTS AND LEFT SIDE HOOD RECEPTACLE.
 - (1) NORMAL FIXED EQUIPMENT CONNECTION SHALL SERVE RIGHT SIDE HOOD RECEPTACLE.
 - (4) NORMAL FIXED EQUIPMENT CONNECTIONS SHALL SERVE DEDICATED DUPLEX CONVENIENCE RECEPTACLES ON CASEWORK.
 - (1) NORMAL FIXED EQUIPMENT CONNECTION SHALL SERVE VACUUM PUMP RECEPTACLE.
 - (1) NORMAL FIXED EQUIPMENT CONNECTION SHALL SERVE VACUUM PUMP RECEPTACLE WHERE INDICATED. CASEWORK AND VACUUM PUMP RECEPTACLES SHALL BE FURNISHED WITH PREWIRED MC CABLE WHIPS BY CASEWORK SUPPLIER. EC SHALL INSTALL MC CABLE WHIPS TO TOP OF FUME HOOD AND CONNECT TO JUNCTION BOX AT TOP OF FUME HOOD.
- PROVIDE (6) SPARE 3/4" CONDUITS TO ACCESSIBLE LOCATION ABOVE CEILING OR BELOW FLOOR FOR EACH RECESSED PANEL/BOX PER SPECIFICATION SECTION 29.24.16.
- PROVIDE 120V, 20A POWER CONNECTION TO MOTORIZED WINDOW SHADES. INSTALL SHADE CONTROLS PER MANUFACTURERS REQUIREMENTS.
- ROUTE POWER FOR SURFACE MOUNTED RACEWAY DOWN FROM CEILING AT THIS LOCATION. PROVIDE 2-CHANNEL RACEWAY VERTICALLY FROM TOP OF FUME HOOD INTO HORIZONTAL 2-CHANNEL RACEWAY.
- PROVIDE 2-CHANNEL SURFACE MOUNTED RACEWAY MOUNTED ON BACK OF FUME HOODS AS SHOWN. SMF CONDUIT AND WIRING IS TO BE ROUTED FROM CEILING. MOUNT ABOVE SURFACE MOUNTED PLUMBING CHANNEL SYSTEM.
- PROVIDE 2-CHANNEL SURFACE MOUNTED RACEWAY MOUNTED TO SIDE OF FUME HOOD.
- REPLACE EXISTING PANEL NAMEPLATE WITH NEW NAMEPLATE TO REVISE PANEL NAME FROM TL4NPL1 TO TL4NPL9. REPLACE JUNCTION BOX AND WIRING DEVICE IDENTIFICATION TAG WITH UPDATED PANEL NAME.
- PROVIDE POKE THROUGH WIREMOLD EVOLUTION (KORTPAK OR EQUAL) FOR POWER, DATA AND AV WITH (2) 120V, 20A DUPLEX RECEPTACLES IN FLOOR BOX, WITH POWER, DATA AND AV. ELECTRICAL CONTRACTOR TO REMOVE J-BOX FROM BASE AND EXTEND CONDUIT STUB THROUGH FLOOR.
- ROUTE POWER CONDUIT AND WIRING FROM CEILING INTO UMBILICAL. PROVIDE 2-CHANNEL SURFACE MOUNTED RACEWAY MOUNTED TO VERTICAL POSTS BELOW BOTTOM SHELF OF CASEWORK.
- MOUNT CONDUIT THROUGH THIS ROOM TIGHT TO STRUCTURE TO COORDINATE WITH MECHANICAL DUCTWORK.
- PROVIDE 120V, 20A CONNECTION TO SWITCHED DEDICATED RECEPTACLE INSTALLED INSIDE CABINET FOR VACUUM PUMP. SWITCH IS INTEGRAL TO FUME HOOD CABINET. COORDINATE EXACT LOCATION AND REQUIREMENTS WITH FUME HOOD VENDOR PRIOR TO ROUGH-IN.
- ADA FUME HOODS:
 - (1) STANDBY FIXED EQUIPMENT CONNECTION SHALL SERVE THE LOW FLOW ALARM.
 - (1) NORMAL FIXED EQUIPMENT CONNECTION SHALL SERVE HOOD LIGHTS AND LEFT SIDE HOOD RECEPTACLE.
 - (1) NORMAL FIXED EQUIPMENT CONNECTION SHALL SERVE RIGHT SIDE HOOD RECEPTACLE.
 - (2) NORMAL FIXED EQUIPMENT CONNECTIONS SHALL SERVE DEDICATED DUPLEX CONVENIENCE RECEPTACLES ON CASEWORK.
 - (1) NORMAL FIXED EQUIPMENT CONNECTION SHALL SERVE VACUUM PUMP RECEPTACLE. CASEWORK AND VACUUM PUMP RECEPTACLES SHALL BE FURNISHED WITH PREWIRED MC CABLE WHIPS BY CASEWORK SUPPLIER. EC SHALL INSTALL MC CABLE WHIPS TO TOP OF FUME HOOD AND CONNECT TO JUNCTION BOX AT TOP OF FUME HOOD.



811 EAST WASHINGTON AVE
 MADISON, WI 53703
 T 608 276 9200

Consultant:
AEI Affiliated Engineers
 Affiliated Engineers, Inc.
 5802 Research Park Boulevard
 Madison, Wisconsin 53719
 Tel 608.236.2616 Fax 608.238.2614

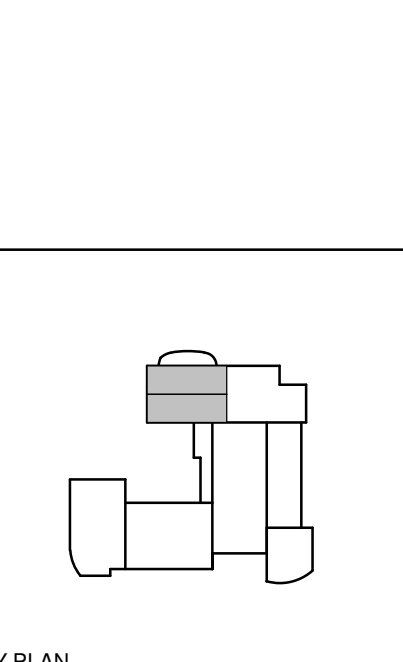

The Board of Regents of the University of Wisconsin on behalf of the University of Wisconsin - Madison




Project Title: CHEMISTRY 2ND AND 4TH FLOOR LAB RENOVATION
Agency/Institution: UNIVERSITY OF WISCONSIN-MADISON
Sheet Title: ELECTRICAL POWER PLAN 4TH (WEST)

Revisions

No.	Date	Description
1	9/19/2023	ADDENDUM #2

Graphic Scale	
UWSA#	A-22-015
Set Type	BD
Date Issued	08/24/2023
Sheet Number	E104.1

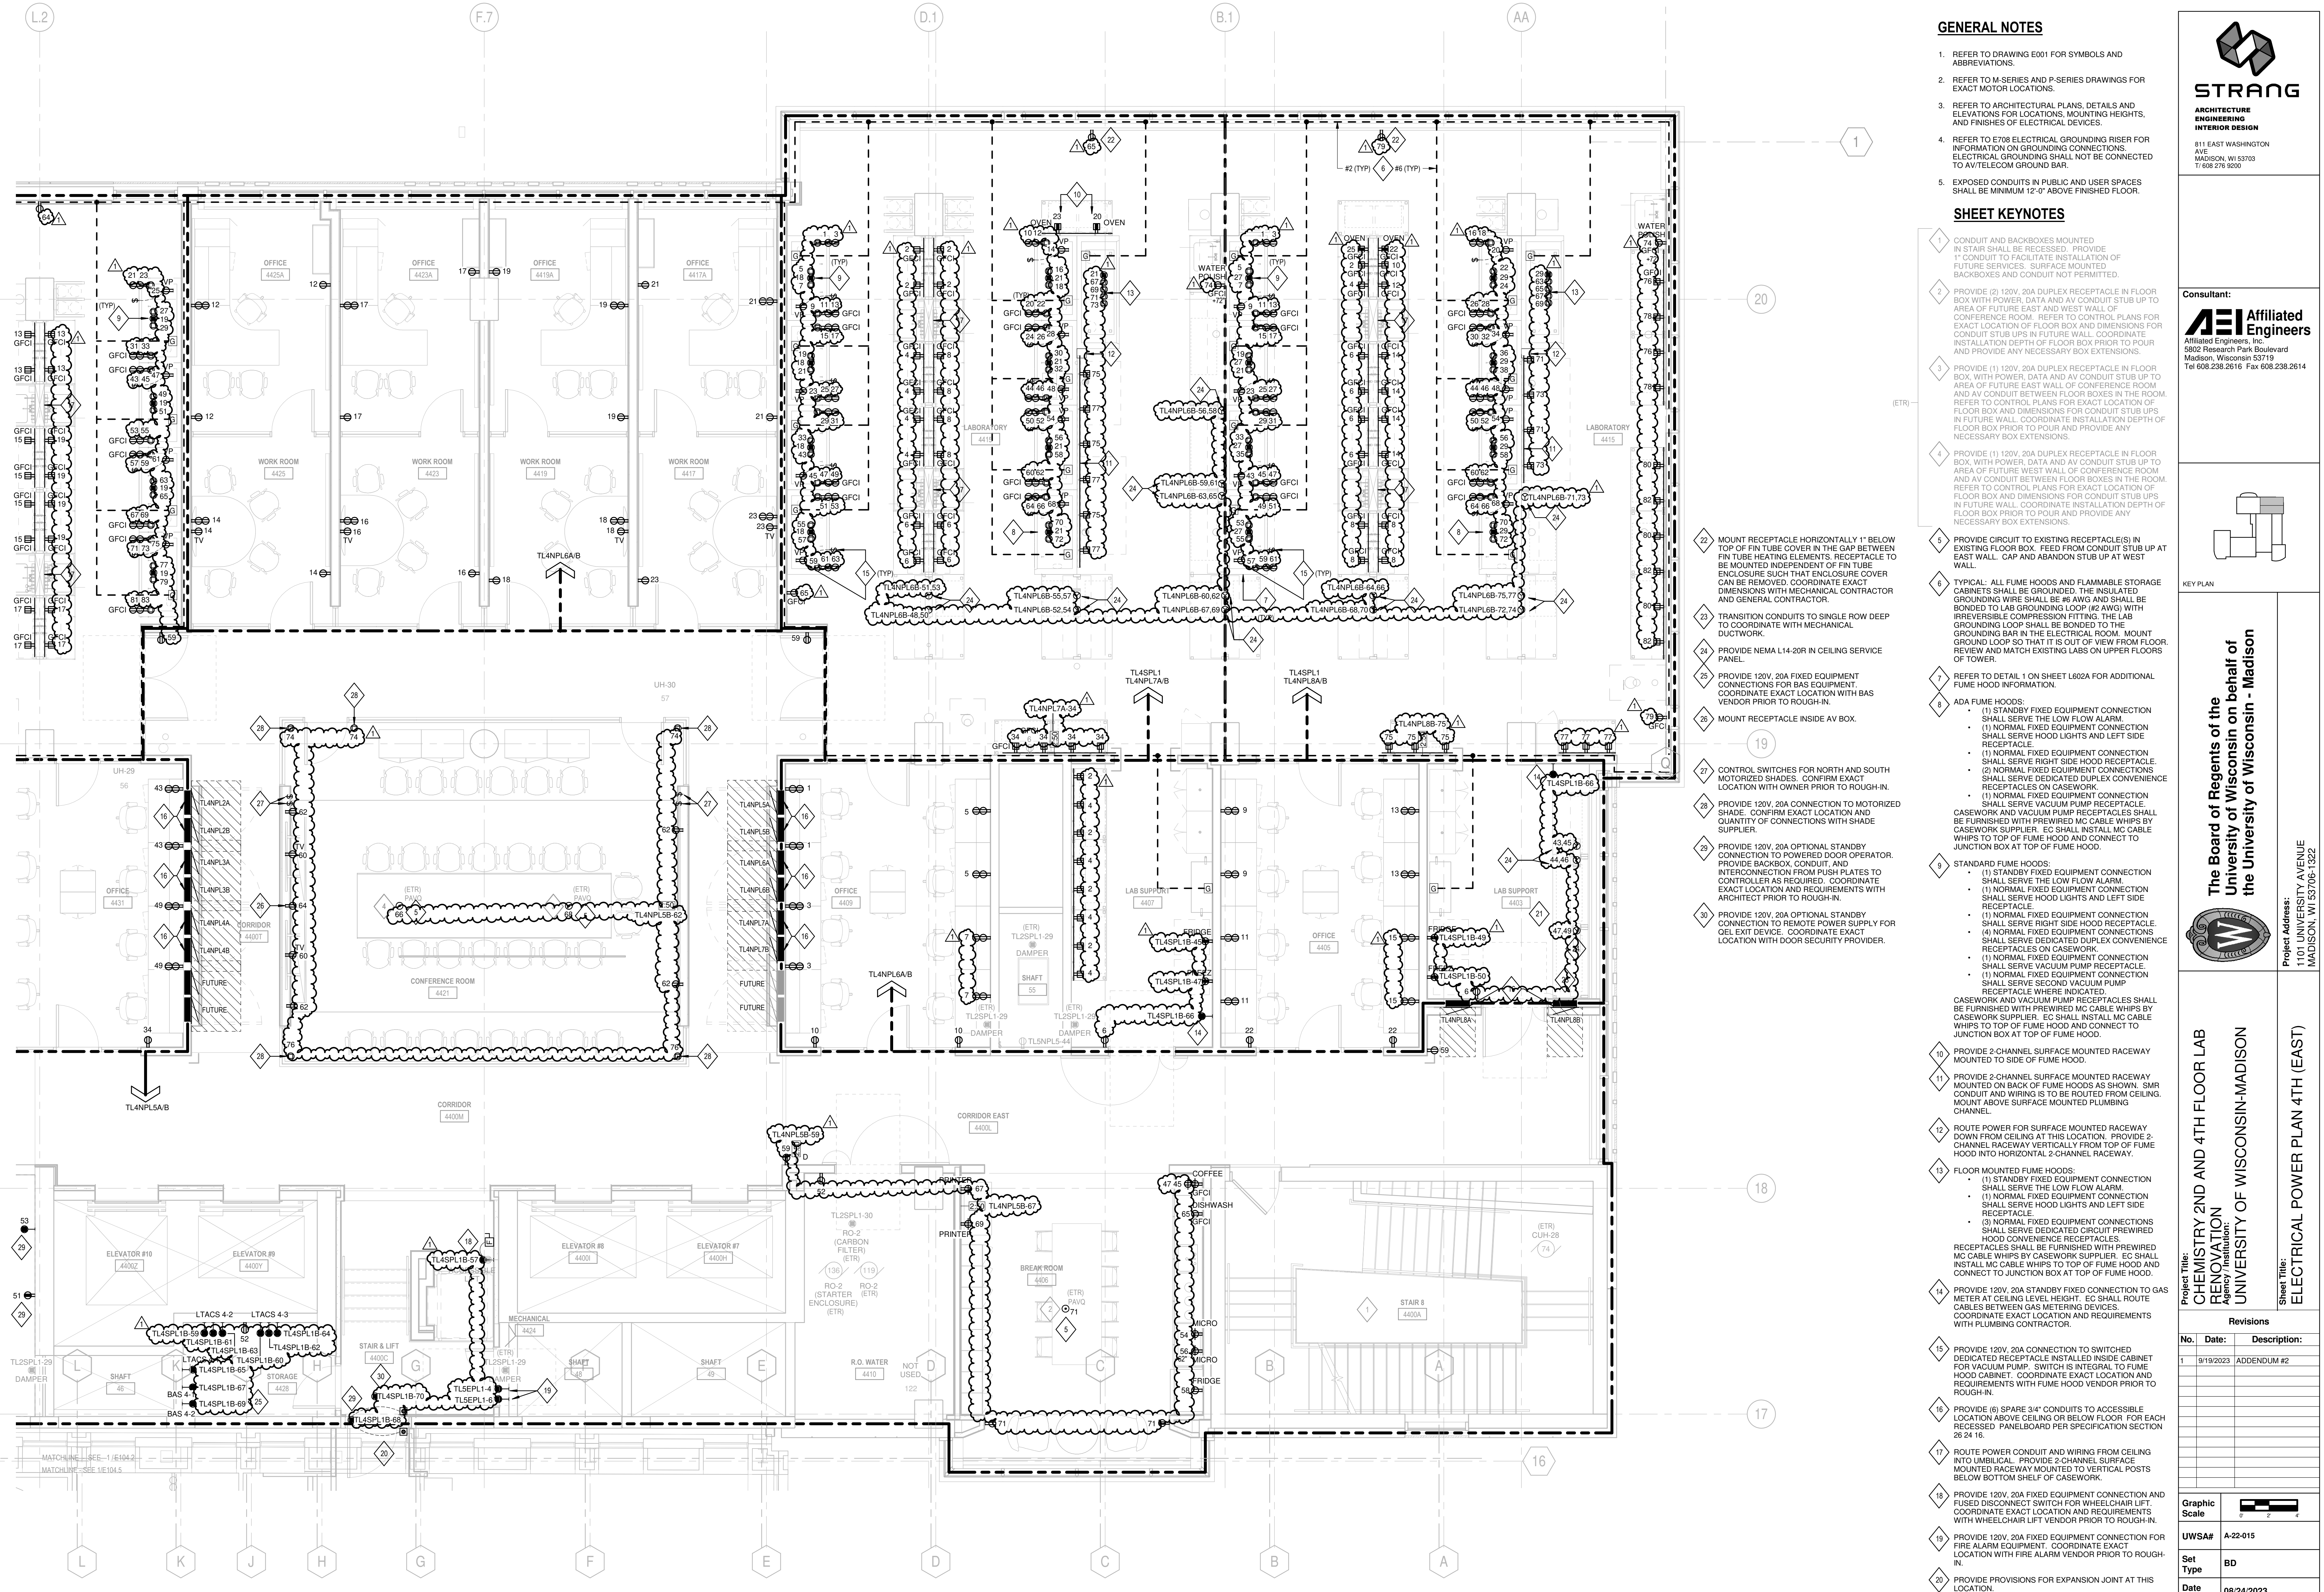

GENERAL NOTES

- REFER TO DRAWING E001 FOR SYMBOLS AND ABBREVIATIONS.
- REFER TO M-SERIES AND P-SERIES DRAWINGS FOR EXACT MOTOR LOCATIONS.
- REFER TO ARCHITECTURAL PLANS, DETAILS AND ELEVATIONS FOR LOCATIONS, MOUNTING HEIGHTS, AND FINISHES OF ELECTRICAL DEVICES.
- REFER TO E708 ELECTRICAL GROUNDING RISER FOR INFORMATION ON GROUNDING CONNECTIONS.
- ELECTRICAL GROUNDING SHALL NOT BE CONNECTED TO AV/TELECOM GROUND BAR.
- EXPOSED CONDUITS IN PUBLIC AND USER SPACES SHALL BE MINIMUM 12'-0" ABOVE FINISHED FLOOR.


SHEET KEYNOTES

- CONDUIT AND BACKBOXES MOUNTED IN STAIR SHALL BE RECESSED. PROVIDE 1" CONDUIT TO FACILITATE INSTALLATION OF FUTURE SERVICES. SURFACE MOUNTED BACKBOXES AND CONDUIT NOT PERMITTED.
- PROVIDE (2) 120V, 20A DUPLEX RECEPTACLE IN FLOOR BOX WITH POWER, DATA AND AV CONDUIT STUB UP TO AREA OF FUTURE EAST AND WEST WALL OF CONFERENCE ROOM. REFER TO CONTROL PLANS FOR EXACT LOCATION OF FLOOR BOX AND DIMENSIONS FOR CONDUIT STUB UPS IN FUTURE WALL. COORDINATE INSTALLATION DEPTH OF FLOOR BOX PRIOR TO POUR AND PROVIDE ANY NECESSARY BOX EXTENSIONS.
- PROVIDE (1) 120V, 20A DUPLEX RECEPTACLE IN FLOOR BOX WITH POWER, DATA AND AV CONDUIT STUB UP TO AREA OF FUTURE WEST WALL OF CONFERENCE ROOM AND AV CONDUIT BETWEEN FLOOR BOXES IN THE ROOM. REFER TO CONTROL PLANS FOR EXACT LOCATION OF FLOOR BOX AND DIMENSIONS FOR CONDUIT STUB UPS IN FUTURE WALL. COORDINATE INSTALLATION DEPTH OF FLOOR BOX PRIOR TO POUR AND PROVIDE ANY NECESSARY BOX EXTENSIONS.
- PROVIDE (1) 120V, 20A DUPLEX RECEPTACLE IN FLOOR BOX WITH POWER, DATA AND AV CONDUIT STUB UP TO AREA OF FUTURE WEST WALL OF CONFERENCE ROOM AND AV CONDUIT BETWEEN FLOOR BOXES IN THE ROOM. REFER TO CONTROL PLANS FOR EXACT LOCATION OF FLOOR BOX AND DIMENSIONS FOR CONDUIT STUB UPS IN FUTURE WALL. COORDINATE INSTALLATION DEPTH OF FLOOR BOX PRIOR TO POUR AND PROVIDE ANY NECESSARY BOX EXTENSIONS.
- PROVIDE CIRCUIT TO EXISTING RECEPTACLE(S) IN EXISTING FLOOR BOX FROM CONDUIT STUB UP AT EAST WALL. CAP AND ABANDON STUB UP AT WEST WALL.
- TYPICAL: ALL FUME HOODS AND FLAMMABLE STORAGE CABINETS SHALL BE GROUNDED. THE INSULATED GROUNDING WIRE SHALL BE AWG AND SHALL BE BONDED TO LAB GROUNDING LOOP (#2 AWG) WITH IRREVERSIBLE COMPRESSION FITTING. THE LAB GROUNDING LOOP SHALL BE BONDED TO THE GROUNDING BAR IN THE ELECTRICAL ROOM. MOUNT GROUND LOOP SO THAT IT IS OUT OF VIEW FROM FLOOR. REVIEW AND MATCH EXISTING LABS ON UPPER FLOORS OF TOWER.
- REFER TO DETAIL 1 ON SHEET L602A FOR ADDITIONAL FUMA HOOD INFORMATION.
- ADA FUME HOODS:
 - (1) STANDBY FIXED EQUIPMENT CONNECTION SHALL SERVE THE LOW FLOW ALARM.
 - (1) NORMAL FIXED EQUIPMENT CONNECTION SHALL SERVE HOOD LIGHTS AND LEFT SIDE RECEPTACLE.
 - (1) NORMAL FIXED EQUIPMENT CONNECTION SHALL SERVE RIGHT SIDE HOOD RECEPTACLE.
 - (2) NORMAL FIXED EQUIPMENT CONNECTIONS SHALL SERVE DEDICATED DUPLEX CONVENIENCE RECEPTACLES ON CASEWORK.
 - (1) NORMAL FIXED EQUIPMENT CONNECTION SHALL SERVE VACUUM PUMP RECEPTACLE.
 - (1) NORMAL FIXED EQUIPMENT CONNECTION SHALL SERVE DEDICATED DUPLEX CONVENIENCE RECEPTACLES ON CASEWORK.
 - (4) NORMAL FIXED EQUIPMENT CONNECTIONS SHALL SERVE VACUUM PUMP RECEPTACLE.
 CASEWORK AND VACUUM PUMP RECEPTACLES SHALL BE FURNISHED WITH PREWIRED MC CABLE WHIPS BY CASEWORK SUPPLIER. EC SHALL INSTALL MC CABLE WHIPS TO TOP OF FUME HOOD AND CONNECT TO JUNCTION BOX AT TOP OF FUME HOOD.
- STANDARD FUME HOODS:
 - (1) STANDBY FIXED EQUIPMENT CONNECTION SHALL SERVE THE LOW FLOW ALARM.
 - (1) NORMAL FIXED EQUIPMENT CONNECTION SHALL SERVE HOOD LIGHTS AND LEFT SIDE RECEPTACLE.
 - (1) NORMAL FIXED EQUIPMENT CONNECTION SHALL SERVE RIGHT SIDE HOOD RECEPTACLE.
 - (4) NORMAL FIXED EQUIPMENT CONNECTIONS SHALL SERVE DEDICATED DUPLEX CONVENIENCE RECEPTACLES ON CASEWORK.
 - (1) NORMAL FIXED EQUIPMENT CONNECTION SHALL SERVE VACUUM PUMP RECEPTACLE.
 - (1) NORMAL FIXED EQUIPMENT CONNECTION SHALL SERVE SECOND VACUUM PUMP RECEPTACLE WHERE INDICATED.
 CASEWORK AND VACUUM PUMP RECEPTACLES SHALL BE FURNISHED WITH PREWIRED MC CABLE WHIPS BY CASEWORK SUPPLIER. EC SHALL INSTALL MC CABLE WHIPS TO TOP OF FUME HOOD AND CONNECT TO JUNCTION BOX AT TOP OF FUME HOOD.
- PROVIDE 2-CHANNEL SURFACE MOUNTED RACEWAY MOUNTED TO SIDE OF FUME HOOD.
- PROVIDE 2-CHANNEL SURFACE MOUNTED RACEWAY MOUNTED ON BACK OF FUME HOODS AS SHOWN. SMR CONDUIT AND WIRING IS TO BE ROUTED FROM CEILING. MOUNT ABOVE SURFACE MOUNTED PLUMBING CHANNEL.
- ROUTE POWER FOR SURFACE MOUNTED RACEWAY DOWN FROM CEILING AT THIS LOCATION. PROVIDE 2-CHANNEL RACEWAY VERTICALLY FROM TOP OF FUME HOOD INTO HORIZONTAL 2-CHANNEL RACEWAY.
- FLOOR MOUNTED FUME HOODS:
 - (1) STANDBY FIXED EQUIPMENT CONNECTION SHALL SERVE THE LOW FLOW ALARM.
 - (1) NORMAL FIXED EQUIPMENT CONNECTION SHALL SERVE HOOD LIGHTS AND LEFT SIDE RECEPTACLE.
 - (3) NORMAL FIXED EQUIPMENT CONNECTIONS SHALL SERVE DEDICATED CIRCUIT PREWIRED HOOD CONVENIENCE RECEPTACLES.
 RECEPTACLES SHALL BE FURNISHED WITH PREWIRED MC CABLE WHIPS BY CASEWORK SUPPLIER. EC SHALL INSTALL MC CABLE WHIPS TO TOP OF FUME HOOD AND CONNECT TO JUNCTION BOX AT TOP OF FUME HOOD.
- PROVIDE 120V, 20A STANDBY FIXED CONNECTION TO GAS METER AT CEILING LEVEL HEIGHT. EC SHALL ROUTE CABLES BETWEEN GAS METERING DEVICES. COORDINATE EXACT LOCATION AND REQUIREMENTS WITH PLUMBING CONTRACTOR.
- PROVIDE (6) SPARE 3/4" CONDUITS TO ACCESSIBLE LOCATION ABOVE CEILING OR BELOW FLOOR FOR EACH RECESSED PANELBOARD PER SPECIFICATION SECTION 26 24 16.
- ROUTE POWER CONDUIT AND WIRING FROM CEILING INTO UMBRICAL. PROVIDE 2-CHANNEL SURFACE MOUNTED RACEWAY MOUNTED TO VERTICAL POSTS BELOW BOTTOM SHELF OF CASEWORK.
- PROVIDE 120V, 20A FIXED EQUIPMENT CONNECTION AND FUSED DISCONNECT SWITCH FOR WHEELCHAIR LIFT. COORDINATE EXACT LOCATION AND REQUIREMENTS WITH WHEELCHAIR LIFT VENDOR PRIOR TO ROUGH-IN.
- PROVIDE 120V, 20A FIXED EQUIPMENT CONNECTION FOR FIRE ALARM EQUIPMENT. COORDINATE EXACT LOCATION WITH FIRE ALARM VENDOR PRIOR TO ROUGH-IN.
- PROVIDE PROVISIONS FOR EXPANSION JOINT AT THIS LOCATION.
- MOUNT CONDUIT THROUGH THIS ROOM TIGHT TO STRUCTURE TO COORDINATE WITH MECHANICAL DUSTWORK.



811 EAST WASHINGTON AVE MADISON, WI 53703 T 608 276 9200

Consultant:
AEL Affiliated Engineers
 Affiliated Engineers, Inc.
 5802 Research Park Boulevard
 Madison, Wisconsin 53719
 Tel 608.238.2616 Fax 608.238.2614

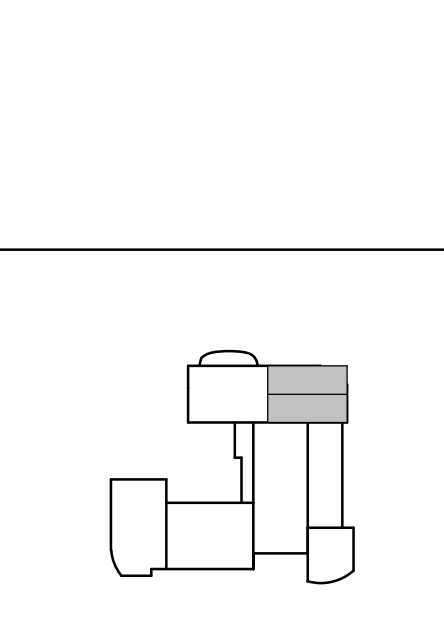

The Board of Regents of the University of Wisconsin on behalf of the University of Wisconsin - Madison


Project Address: 1101 UNIVERSITY AVENUE MADISON, WI 53706-1322

Project Title: **CHEMISTRY 2ND AND 4TH FLOOR LAB RENOVATION**
 Agency/Institution: **UNIVERSITY OF WISCONSIN-MADISON**
 Sheet Title: **ELECTRICAL POWER PLAN 4TH (EAST)**

Revisions		
No.	Date	Description
1	9/19/2023	ADDENDUM #2

Graphic Scale	
UWSA#	A-22-015
Set Type	BD
Date Issued	08/24/2023
Sheet Number	E104.2

ELECTRICAL POWER PLAN - 4TH (EAST)
 SCALE: 1/4" = 1'-0"

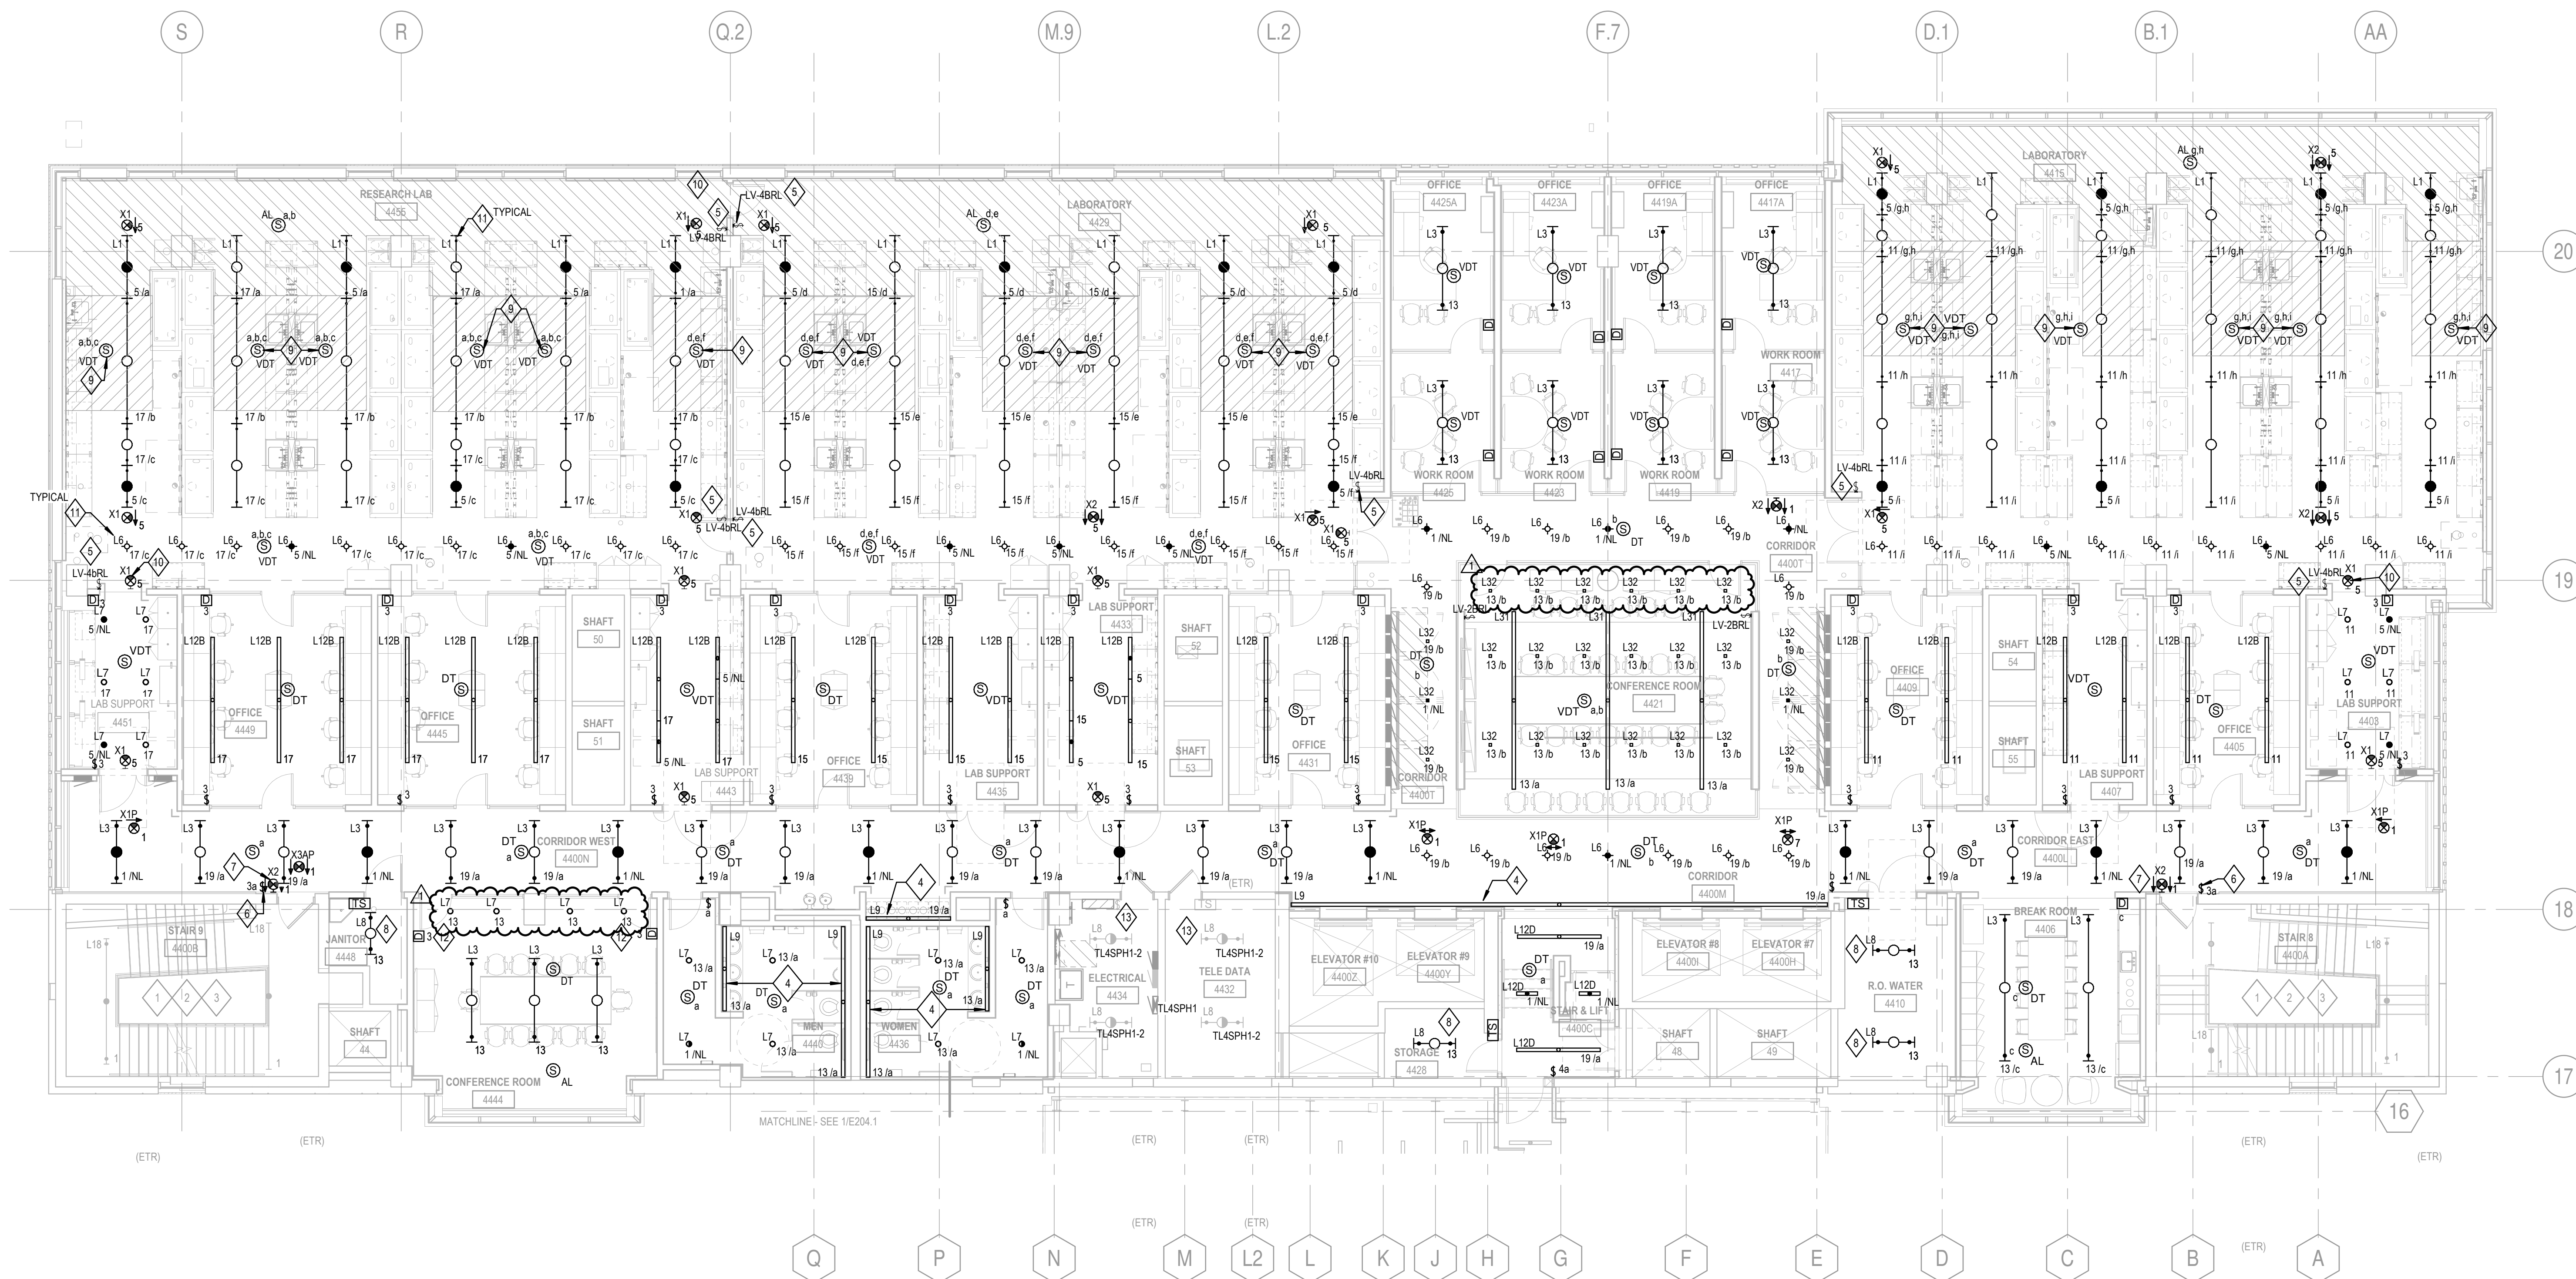

ELECTRICAL LIGHTING PLAN - 4TH FLOOR
 SCALE: 1/8" = 1'-0"

- GENERAL NOTES**
- REFER TO DRAWING E001 FOR SYMBOLS AND ABBREVIATIONS.
 - REFER TO SHEET E904 FOR LUMINAIRE SCHEDULE.
 - FIRE-RATE ALL PENETRATIONS AS REQUIRED BY CODE. REFER TO ARCHITECTURAL DOCUMENTS FOR LOCATION OF FIRE-RATE WALLS, WALL TYPES, INTERIOR ELEVATIONS AND CEILING TYPES.
 - REFER TO ARCHITECTURAL ELEVATIONS AND FLOOR PLANS FOR EXACT DEVICE LOCATIONS AND ORIENTATION. ELECTRICAL DRAWINGS INDICATE DEVICE QUANTITIES AND RELATIVE LOCATION BUT EXACT LOCATION AND ELEVATION SHALL BE PER ARCHITECTURAL DRAWINGS. IN THE ABSENCE OF AN ARCHITECTURAL ELEVATION, ELECTRICAL DRAWINGS SHALL TAKE PRECEDENCE.
 - OCCUPANCY SENSORS SHALL CONTROL ALL LUMINAIRES WITH SWITCH LEGS IN ROOM IN WHICH THEY ARE INSTALLED. PROVIDE QUANTITY OF SENSORS AS REQUIRED FOR FULL COVERAGE OF ROOM. IN ROOMS WITH MORE THAN ONE SENSOR ALL SENSORS SHALL BE TIED TOGETHER.
 - ALL ROOMS WITH OCCUPANCY SENSORS SHALL HAVE AUXILIARY CONTACTS FOR HVAC CONTROL EXCEPT CORRIDORS.
 - INDUSTRIAL TYPE LUMINAIRES IN UNFINISHED AREAS, WHICH ARE NEAR OBSTRUCTIONS SUCH AS DUCTS AND PIPES, SHALL BE:
 - SUSPENDED SO THAT BOTTOM OF LUMINAIRE IS NO HIGHER THAN BOTTOM OF OBSTRUCTION.
 - LOCATED AT HEIGHT OF LOWEST LUMINAIRE.
 - MINIMUM HEIGHT: 8'-0"
 - SHALL NOT BE LOCATED UNTIL LOCATIONS OF OBSTRUCTIONS ARE DETERMINED.
 - EXPOSED CONDUITS IN PUBLIC AND USER SPACES SHALL BE MINIMUM 12'-0" ABOVE FINISHED FLOOR.
 - EMERGENCY LIGHTING SHALL BE FED FROM PANEL TLSEPH1 UNLESS OTHERWISE NOTED.
 - OPTIONAL STANDBY LIGHTING SHALL BE FED FROM PANEL TLSPH1 UNLESS OTHERWISE NOTED.
 - NORMAL LIGHTING SHALL BE FED FROM PANEL TLSPH1 UNLESS OTHERWISE NOTED.
 - PROVIDE UL-924 LISTED EMERGENCY TRANSFER DEVICE FOR LIGHTING WITH SWITCH TAG ON EMERGENCY POWER. WATT STOPPER ECU-200, OR APPROVED EQUAL. FOR EACH SWITCHED CIRCUIT PROVIDE UNSWITCHED EMERGENCY POWER AND UNSWITCHED NORMAL POWER TO TRANSFER DEVICE.
 - PROVIDE THE COST FOR THREE ADDITIONAL EXIT SIGNS FOR THIS WORK AREA. COST TO INCLUDE MATERIAL, LABOR, OVERHEAD AND PROFIT. LOCATE SIGNS AS REQUIRED BY INSPECTOR.


LIGHTING CONTROL MATRIX (UW CHEMISTRY 4TH FLOOR FIT OUT AND 2ND FLOOR RENOVATION)

Space Description	NORMAL HOURS OF OPERATION							AFTER HOURS OPERATION			
	Manual On	Sensor On	Wall Switch Override	Sensor Off	Local Control	Daylight Zones	HVAC Aux Contact	Seq. Notes	Manual On	Sensor On	Sensor Off
Collaboration Spaces		100%	X	15 min	Low Voltage			X		100%	20 min
Common Area/Entry (2nd floor only)		100%	X	15 min	Low Voltage					100%	
Public Corridor (4th floor only)		100%		15 min	Low Voltage					100%	
Fac Office/Work Interview, Office (2nd floor only)	X	50%	X	15 min	Dimmer		X		X	50%	15 min
RA Office (4th floor only)	X	50%	X	15 min	Dimmer		X		X	50%	15 min
FAC Office, Fac Work (4th floor only)	X	X	X	15 min	Dimmer		X		X	X	15 min
Conference Room (4th floor only)	X	50%	X	15 min	Dimmer		X		X	50%	15 min
Labs (4th floor only)	X		X	15 min	Dimmer	50%	X		X		15 min
Lab Support (4th floor only)	X		X	15 min	Dimmer		X		X		15 min
Public Toilets (4th floor only)	X	100%	X	15 min	Switch		X		X	100%	15 min
Equipment Room (4th floor only)	X				Switch				X		
Electrical Room (4th floor only)	X								X		
Storage, R.O. Water, J.C.	X			5 min	Switch				X		5 min

SEQUENCE OF OPERATION NOTES

LAB LOW VOLTAGE CONTROL SCHEDULE (UW CHEMISTRY 4TH FLOOR FIT OUT)

Design No.	Location	Zone(s) Controlled	Buttons	Blink Warn	Time Sched	Button	Description	Notes
LV-4RL	LABS	a,b,c	4+RL	Y		B1 = 100%	On 100%	1,2
						B2 = 75%	On 75%	1,2
						B3 = 50%	On 50%	1,2
						B4 = 25%	On 25%	1,2
		(ON/Raise)/OFF/Lower	Dimming for buttons 1-4					
LV-4RL	LAB 4429	d,e,f	4+RL	Y		B1 = 100%	On 100%	1,3
						B2 = 75%	On 75%	1,3
						B3 = 50%	On 50%	1,3
						B4 = 25%	On 25%	1,3
		(ON/Raise)/OFF/Lower	Dimming for buttons 1-4					
LV-4RL	LAB 4415	g,h,i	4+RL	Y		B1 = 100%	On 100%	1,4
						B2 = 75%	On 75%	1,4
						B3 = 50%	On 50%	1,4
						B4 = 25%	On 25%	1,4
		(ON/Raise)/OFF/Lower	ON/OFF Dimming for buttons 1-4					

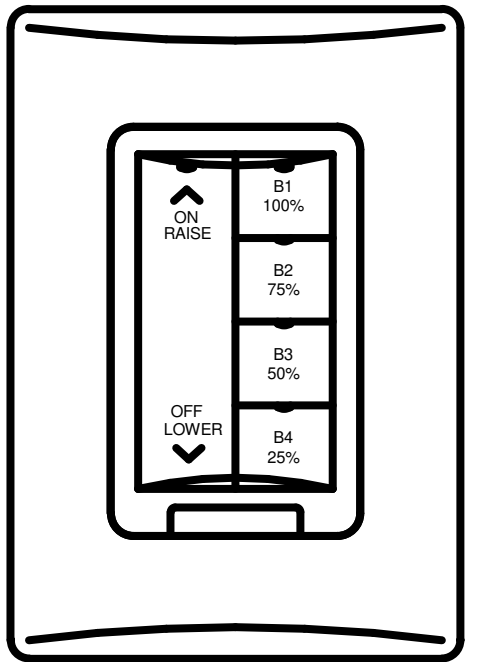


LAB LOW VOLTAGE SWITCH NOTES:
 1. TAP TOP OF ON/RAISE BUTTON TO TURN ALL LIGHTS ON TO 100%
 2. TAP BOTTOM OFF/LOWER BUTTON TO TURN ALL LIGHTS OFF
 3. PRESS AND HOLD TOP OF ON/RAISE BUTTON TO RAISE THE LIGHT LEVEL OF SELECTED SCENE BUTTON
 4. PRESS AND HOLD BOTTOM OF OFF/LOWER BUTTON TO LOWER THE LIGHT LEVEL OF SELECTED SCENE BUTTON

LAB LOW VOLTAGE CONTROL NOTES:
 1. Occupancy sensor are set for manual occupancy.
 2. Ambient light sensor to dim lights to 20% if daylight provides levels above 50% for switch "a,b" only.
 3. Ambient light sensor to dim lights to 20% if daylight provides levels above 50% for switch "d,e" only.
 4. Ambient light sensor to dim lights to 20% if daylight provides levels above 50% for switch "g,h" only.

LOW VOLTAGE SWITCH NOMENCLATURE (L.V.)
 4RL = 4 Buttons with (ON/Raise)/OFF/Lower

ELECTRICAL ROOM 5434 - 5TH (WEST)
 SCALE: 1/8" = 1'-0"

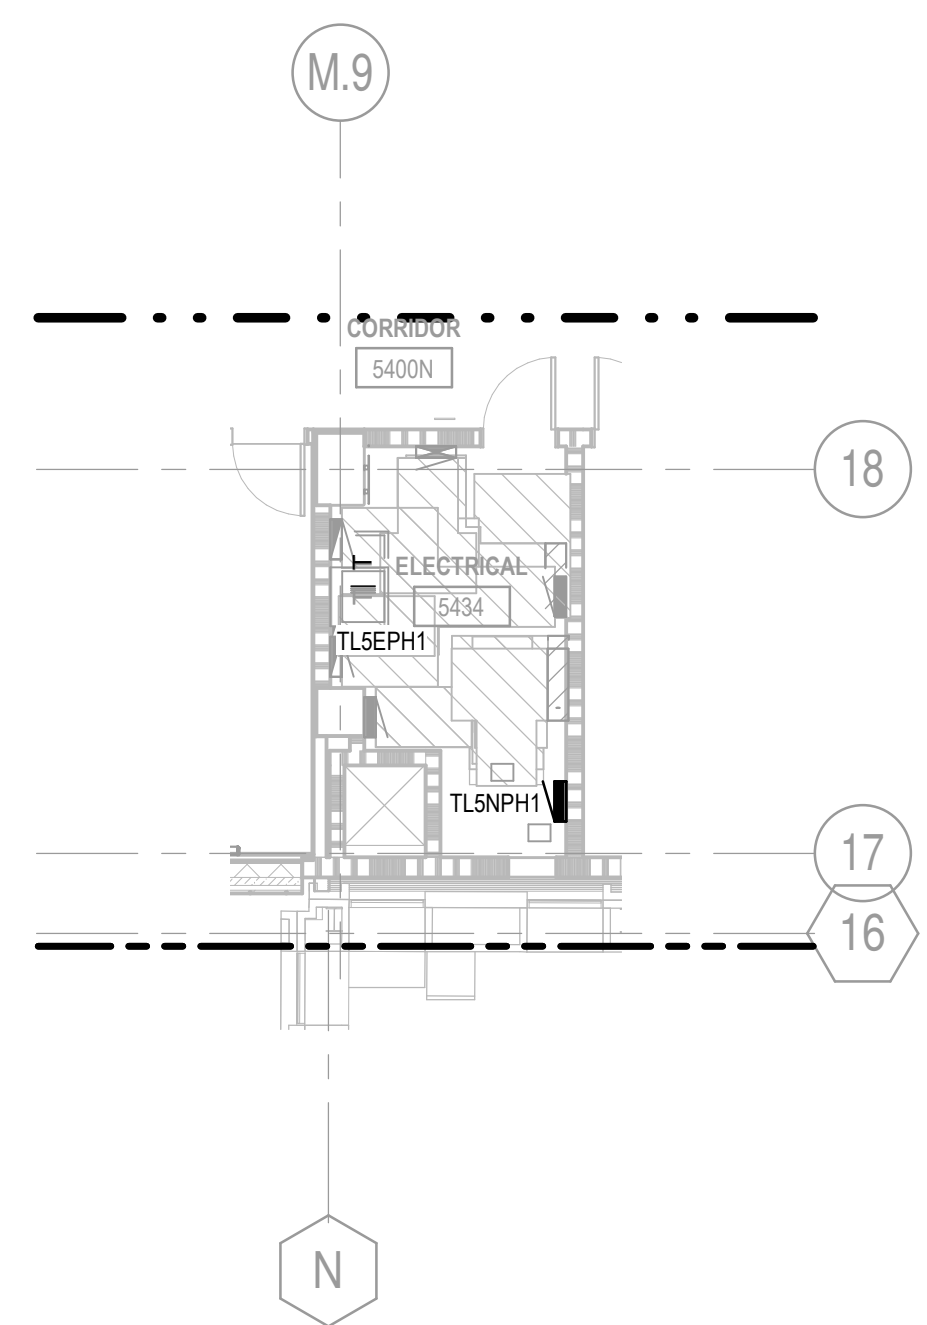

SHEET KEYNOTES


- STAIRWELLS SHALL BE REDUCED TO 50% WHEN UNOCCUPIED.
- OCCUPANCY SENSOR SHALL BE INTEGRAL TO FIXTURES IN STAIRWELLS.
- CONDUIT AND BACKBOXES MOUNTED IN STAIR SHALL BE RECESSED. PROVIDE 1" CONDUIT TO FACILITATE INSTALLATION OF FIXTURE SERVICES. SURFACE MOUNTED BACKBOXES AND CONDUIT NOT PERMITTED.
- LUMINAIRE SHALL RUN CONTINUOUS FROM WALL TO WALL AND ILLUMINATE THE ENTIRE LENGTH.
- EACH SWITCH WITHIN LAB SHALL HAVE THE SAME FUNCTIONALITY. REFER TO SCHEDULE THIS SHEET.
- EXISTING SWITCH LOCATION SHALL BE REWORKED TO SWITCH CORRIDOR LIGHTING.
- NEW EXIT SIGN SHALL REPLACE EXISTING SINGLE SIDED EXIT SIGN.
- REUSE EXISTING TYPE L8 LUMINAIRE FROM SHELL SPACE DEMOLITION.
- OCCUPANCY SENSOR SHALL BE MOUNTED SO THAT BOTTOM FACE OF SENSOR IS FLUSH WITH BOTTOM OF LUMINAIRE.
- ELECTRICAL CONTRACTOR TO RELOCATE EXISTING EXIT SIGN TO THIS LOCATION.
- PROVIDE ADDITIONAL LUMINAIRE SUPPORTS AND OR OTHER SUPPORTING METHODS TO MOUNT LUMINAIRES. COORDINATE WITH OTHER TRADES TO PROVIDE COMPLETE INSTALLATION.
- DIMMING SHALL BE PROVIDED AT BOTH LOCATIONS IN ROOM.
- DISCONNECT EXISTING LUMINAIRES IN THIS ROOM FROM PANEL TLSEPH1, CIRCUIT 2 AND REFEED FROM PANEL TLSPH1.



Consultant:
AEI Affiliated Engineers
 Affiliated Engineers, Inc.
 5802 Research Park Boulevard
 Madison, Wisconsin 53719
 Tel 608.238.2616 Fax 608.238.2614

KEY PLAN

The Board of Regents of the
 University of Wisconsin on behalf of
 the University of Wisconsin - Madison

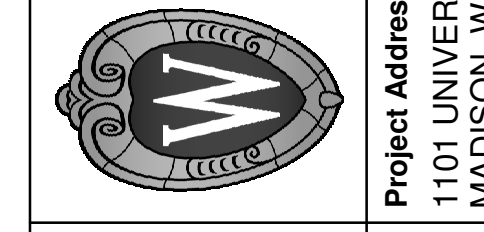

Project Title:
CHEMISTRY 2ND AND 4TH FLOOR LAB RENOVATION
 Agency/Institution:
UNIVERSITY OF WISCONSIN-MADISON

Revisions

No.	Date:	Description:
1	09/19/23	ADDENDUM #2

Graphic Scale: 1" = 10'
 UWAS# A-22-015
 Set Type BD
 Date Issued 08/24/2023
 Sheet Number E204

TL4NPL1A													
MAIN TYPE		MCB		VOLTAGE		120/208 Wye		LOCATION		4TH FLOOR-TOWER-CORRIDO...			
MAIN RATING		150 A		PHASE		3 PHASE 4 WIRE		FED FROM		TL4NPL1A			
BUS RATING		225 A		MOUNTING		RECESSED		SCCR		65 KA			
		ENCLOSURE		TYPE 1		CALCULATED AVAILABLE FAULT...				KA			
REMARKS: FEED THROUGH LUGS													
LEFT SIDE, KVA						RIGHT SIDE, KVA							
DESCRIPTION	BRKR NOTES	BRKR AMP. POLES	CKT NO	A	B	C	A	B	C	CKT NO	BRKR AMP. POLES	BRKR NOTES	DESCRIPTION
REC-4455		20 A	1	1	0.18					2	1	20 A	FH PWR-4455
REC-4455		20 A	1	3	0.72					4	1	20 A	FH PWR-4455
REC-4455		20 A	1	5		0.54				6	1	20 A	FH PWR-4455
REC-4455		20 A	1	7	0.46					8	1	20 A	FH PWR-4455
FH DDR-4455		20 A	1	9	0.18					10	1	20 A	REC-4455
FH DDR-4455		20 A	1	11		0.18				12	1	20 A	REC-4455
FH PWR-4455		20 A	1	13	1.00					14	1	20 A	REC-4455
FH PWR-4455		20 A	1	15	0.50					16	1	20 A	REC-4455
FH VP-4455		20 A	1	17		0.50				18	1	20 A	REC-4455
FH DDR-4455		20 A	1	19	0.18					20	1	20 A	REC-4455
FH DDR-4455		20 A	1	21		0.18				22	1	20 A	REC-4455
FH DDR-4455		20 A	1	23	0.18					24	1	20 A	REC-4455
FH DDR-4455		20 A	1	25	0.18					26	1	20 A	REC-4455
FH VP-4455		20 A	1	27		0.50				28	1	20 A	FH DDR-4455
FH PWR-4455		20 A	1	29	1.00					30	1	20 A	FH DDR-4455
FH PWR-4455		20 A	1	31	0.50					32	1	20 A	FH VP-4455
Spare		20 A	1	33	0.00					34	1	20 A	FH PWR-4455
Spare		20 A	1	35	0.00					36	1	20 A	FH PWR-4455
Spare		20 A	1	37	0.00					38	1	20 A	FH DDR-4455
Spare		20 A	1	39	0.00					40	1	20 A	FH DDR-4455
Spare		20 A	1	41	0.00					42	1	20 A	REC-4455
1ST SECTION PHASE SUBTOTAL (KVA)				5.48 kVA		5.34 kVA		5.24 kVA					
2ND SECTION PHASE SUBTOTAL (KVA)				4.58 kVA		4.76 kVA		4.76 kVA					
ALL SECTIONS PHASE GRAND TOTAL (KVA)				10.06 kVA		10.10 kVA		10.00 kVA					
LOAD CLASSIFICATION		CONNECTED (KVA)		DEMAND FACTOR		DEMAND (KVA)							
POWER	13.86 kVA	100%	13.86 kVA	100%	13.86 kVA	100%	13.86 kVA						
LIGHTING	0.00 kVA	100%	0.00 kVA	100%	0.00 kVA	100%	0.00 kVA						
MOTOR	0.00 kVA	125% LARGEST, 100% OTHER	0.00 kVA	100%	0.00 kVA	100%	0.00 kVA						
RECEPTACLE	16.00 kVA	100% FIRST 10KVA, 50% OTHER	13.10 kVA	100%	13.10 kVA	100%	13.10 kVA						
HEATING	0.00 kVA	100%	0.00 kVA	100%	0.00 kVA	100%	0.00 kVA						
TOTAL LOAD	30.16 kVA		27.06 kVA		27.06 kVA		27.06 kVA						
TOTAL AMPS	84 A		75 A		75 A		75 A						

TL4NPL1B													
MAIN TYPE		MCB		VOLTAGE		120/208 Wye		LOCATION		4TH FLOOR-TOWER-CORRIDO...			
MAIN RATING		150 A		PHASE		3 PHASE 4 WIRE		FED FROM		TL4NPL1A			
BUS RATING		225 A		MOUNTING		RECESSED		SCCR		65 KA			
		ENCLOSURE		TYPE 1		CALCULATED AVAILABLE FAULT...				KA			
REMARKS:													
LEFT SIDE, KVA						RIGHT SIDE, KVA							
DESCRIPTION	BRKR NOTES	BRKR AMP. POLES	CKT NO	A	B	C	A	B	C	CKT NO	BRKR AMP. POLES	BRKR NOTES	DESCRIPTION
FH VP-4455		20 A	1	43	0.50					44	1	20 A	FH DDR-4455
FH DDR-4455		20 A	1	45		0.18				46	1	20 A	FH DDR-4455
FH DDR-4455		20 A	1	47						48	1	20 A	FH VP-4455
FH DDR-4455		20 A	1	49	0.18					50	1	20 A	FH PWR-4455
FH DDR-4455		20 A	1	51	0.18					52	1	20 A	FH PWR-4455
FH PWR-4455		20 A	1	53		0.50				54	1	20 A	REC-4455
FH PWR-4455		20 A	1	55	0.50					56	1	20 A	REC-4455
FH VP-4455		20 A	1	57		0.50				58	1	20 A	FH DDR-4455
FH DDR-4455		20 A	1	59		0.18				60	1	20 A	FH DDR-4455
FH DDR-4455		20 A	1	61	0.18					62	1	20 A	FH VP-4455
FH PWR-4455		20 A	1	63	1.00					64	1	20 A	FH PWR-4455
FH PWR-4455		20 A	1	65		0.50				66	1	20 A	FH VP-4455
FH VP-4455		20 A	1	67	0.50					68	1	20 A	FH DDR-4455
FH DDR-4455		20 A	1	69		0.18				70	1	20 A	FH DDR-4455
FH DDR-4455		20 A	1	71		0.18				72	1	20 A	FH DDR-4455
Spare		20 A	1	73	0.00					74	1	20 A	FH DDR-4455
Spare		20 A	1	75	0.00					76	1	20 A	FH VP-4455
Spare		20 A	1	77	0.00					78	1	20 A	FH PWR-4455
Spare		20 A	1	79	0.00					80	1	20 A	FH VP-4455
Spare		20 A	1	81	0.00					82	1	20 A	FH DDR-4455
Spare		20 A	1	83	0.00					84	1	20 A	FH DDR-4455
1ST SECTION PHASE SUBTOTAL (KVA)				4.58 kVA		4.76 kVA		4.76 kVA					
2ND SECTION PHASE SUBTOTAL (KVA)				38 A		40 A		40 A					
ALL SECTIONS PHASE GRAND TOTAL (KVA)				38 A		40 A		40 A					
LOAD CLASSIFICATION		CONNECTED (KVA)		DEMAND FACTOR		DEMAND (KVA)							
POWER	7.50 kVA	100%	7.50 kVA	100%	7.50 kVA	100%	7.50 kVA						
LIGHTING	0.00 kVA	100%	0.00 kVA	100%	0.00 kVA	100%	0.00 kVA						
MOTOR	0.00 kVA	125% LARGEST, 100% OTHER	0.00 kVA	100%	0.00 kVA	100%	0.00 kVA						
RECEPTACLE	6.60 kVA	100% FIRST 10KVA, 50% OTHER	6.60 kVA	100%	6.60 kVA	100%	6.60 kVA						
HEATING	0.00 kVA	100%	0.00 kVA	100%	0.00 kVA	100%	0.00 kVA						
TOTAL LOAD	14.10 kVA		14.10 kVA		14.10 kVA		14.10 kVA						
TOTAL AMPS	39 A		39 A		39 A		39 A						

TL4NPL2A													
MAIN TYPE		MCB		VOLTAGE		120/208 Wye		LOCATION		4TH FLOOR-TOWER-CORRIDO...			
MAIN RATING		150 A		PHASE		3 PHASE 4 WIRE		FED FROM		TL4NPL1A			
BUS RATING		225 A		MOUNTING		RECESSED		SCCR		65 KA			
		ENCLOSURE		TYPE 1		CALCULATED AVAILABLE FAULT...				KA			
REMARKS: FEED THROUGH LUGS													
LEFT SIDE, KVA						RIGHT SIDE, KVA							
DESCRIPTION	BRKR NOTES	BRKR AMP. POLES	CKT NO	A	B	C	A	B	C	CKT NO	BRKR AMP. POLES	BRKR NOTES	DESCRIPTION
FH DDR-4455		20 A	1	1	0.18					2	1	20 A	REC-4455
FH DDR-4455		20 A	1	3		0.18				4	1	20 A	REC-4455
FH PWR-4455		20 A	1	5						6	1	20 A	REC-4455
FH PWR-4455		20 A	1	7	0.46					8	1	20 A	REC-4455
FH VP-4455		20 A	1	9	0.50					10	1	20 A	REC-4455
FH DDR-4455		20 A	1	11		0.18				12	1	20 A	REC-4455
FH DDR-4455		20 A	1	13	0.18					14	1	20 A	REC-4455
FH DDR-4455		20 A	1	15		0.18				16	1	20 A	REC-4455
FH DDR-4455		20 A	1	17						18	1	20 A	FH DDR-4455
FH PWR-4455		20 A	1	19	1.00					20	1	20 A	FH DDR-4455
FH PWR-4455		20 A	1	21	0.50					22	1	20 A	FH VP-4455
FH VP-4455		20 A	1	23		0.50				24	1	20 A	FH PWR-4455
FH DDR-4455		20 A	1	25	0.18					26	1	20 A	FH PWR-4455
FH DDR-4455		20 A	1	27		0.18				28	1	20 A	FH DDR-4455
FH DDR-4455		20 A	1	29		0.18				30	1	20 A	FH DDR-4455
FH PWR-4455		20 A	1	31	0.18					32	1	20 A	FH DDR-4455
REC-4455		20 A	1	33	0.72					34	1	20 A	FH DDR-4455
REC-4455		20 A	1	35		0.72				36	1	20 A	REC-4455
Spare		20 A	1	37	0.00					38	1	20 A	REC-4455
Spare		20 A	1	39	0.00					40	1	20 A	Spare
Spare		20 A	1	41	0.00					42	1	20 A	Spare
1ST SECTION PHASE SUBTOTAL (KVA)				4.62 kVA		4.74 kVA		5.38 kVA					
2ND SECTION PHASE SUBTOTAL (KVA)				5.58 kVA		5.94 kVA		4.26 kVA					
ALL SECTIONS PHASE GRAND TOTAL (KVA)				10.20 kVA		10.68 kVA		9.64 kVA					
LOAD CLASSIFICATION		CONNECTED (KVA)		DEMAND FACTOR		DEMAND (KVA)							
POWER	14.04 kVA	100%	14.04 kVA	100%	14.04 kVA	100%	14.04 kVA						
LIGHTING	0.00 kVA	100%	0.00 kVA	100%	0.00 kVA	100%	0.00 kVA						
MOTOR	0.00 kVA	125% LARGEST, 100% OTHER	0.00 kVA	100%	0.00 kVA	100%	0.00 kVA						
RECEPTACLE	16.38 kVA	100% FIRST 10KVA, 50% OTHER	13.19 kVA	100%	13.19 kVA	100%	13.19 kVA						
HEATING	0.00 kVA	100%	0.00 kVA	100%	0.00 kVA	100%	0.00 kVA						
TOTAL LOAD	30.52 kVA		27.33 kVA		27.33 kVA		27.33 kVA						
TOTAL AMPS	85 A		76 A		76 A		76 A						

TL4NPL2B											
MAIN TYPE		MCB		VOLTAGE		120/208 Wye		LOCATION		4TH FLOOR-TOWER-CORRIDO...	
MAIN RATING		150 A		PHASE		3 PHASE 4 WIRE		FED FROM		TL4NPL2A	
BUS RATING		225 A		MOUNTING		RECESSED		SCCR		65 KA	
		ENCLOSURE		TYPE 1		CALCULATED AVAILABLE FAULT...				KA	
REMARKS:											
LEFT SIDE, KVA						RIGHT SIDE, KVA					
DESCRIPTION	BRKR NOTES	BRKR AMP. POLES	CKT NO	A	B	C	A	B			

MAIN TYPE		VOLTAGE		LOCATION										
MCB	120/208 Wye	4TH FLOOR TOWER CORRIDOR...	4TH FLOOR TOWER CORRIDOR...	4TH FLOOR TOWER CORRIDOR...	4TH FLOOR TOWER CORRIDOR...									
150 A	PHASE 4 WIRE	TL4NPL5A	TL4NPL5A	TL4NPL5A	TL4NPL5A									
225 A	MOUNTING RECESSED	SCCR 65 kA	SCCR 65 kA	SCCR 65 kA	SCCR 65 kA									
	ENCLOSURE TYPE 1	CALCULATED AVAILABLE FAULT...												
REMARKS:														
LEFT SIDE, kVA			RIGHT SIDE, kVA											
DESCRIPTION	BRKR NOTES	BRKR AMP. POLES	CKT NO	A	B	C	A	B	C	CKT NO	BRKR AMP. POLES	BRKR NOTES	DESCRIPTION	
REC-4431		20 A	1	43	0.72					44				
COFFEE-4406		20 A	1	45	1.20					46			LTO CONTROLS-4434	
REC-4408		20 A	1	47	0.18					48			REC-4432	
REC-4431		20 A	1	49	0.72					50			REC-4432	
REC-4448, 4400N		20 A	1	51	0.82					52			REC-4410,4434	
HAND DRYER-4440		20 A	1	53	0.72					54			MICRO-4406	
REC-4436,4440		20 A	1	55	0.72					56			MICRO-4406	
HAND DRYER-4436		20 A	1	57	0.72					58			FRIDGE-4406	
REC-4400N		20 A	1	59	0.82					60			TV-4421	
EWC-4400N	GFCI	20 A	1	61	0.36					62			REC-4421	
REC-4432		20 A	1	63	0.36					64			REC-4421	
DISHWASHER-4406		20 A	1	65	1.20					66			REC-4421	
PRINTER-4406		20 A	1	67	1.30					68			REC-4421	
REC-4406		20 A	1	69	1.20					70				
Spare		20 A	1	71	0.54					72				
Spare		20 A	1	73	0.00					74			SHADES-4421	
Spare		20 A	1	75	0.00					76			SHADES-4421	
Spare		20 A	1	77	0.00					78			Spare	
Spare		20 A	1	79	0.00					80			Spare	
Spare		20 A	1	81	0.00					82			Spare	
Spare		20 A	1	83	0.00					84			Spare	
PHASE SUBTOTAL (kVA)			6.92 kVA			7.08 kVA			5.56 kVA					
PHASE SUBTOTAL (AMPS)			59 A			61 A			46 A					
LOAD CLASSIFICATION		CONNECTED (kVA)		DEMAND FACTOR		DEMAND (kVA)								
POWER	0.54 kVA	100%	0.54 kVA	100%	0.54 kVA									
LIGHTING	0.00 kVA		0.00 kVA		0.00 kVA									
MOTOR	0.00 kVA	125% LARGEST, 100% OTHER	0.00 kVA		0.00 kVA									
RECEPTACLE	16.62 kVA	100% FIRST 10kVA, 50% OTHER	0.00 kVA		0.00 kVA									
HEATING	0.00 kVA		0.00 kVA		0.00 kVA									
TOTAL LOAD	19.58 kVA		15.25 kVA		15.25 kVA									
TOTAL AMPS	54 A		42 A		42 A									

MAIN TYPE		VOLTAGE		LOCATION										
MCB	120/208 Wye	4TH FLOOR TOWER CORRIDOR...	4TH FLOOR TOWER CORRIDOR...	4TH FLOOR TOWER CORRIDOR...	4TH FLOOR TOWER CORRIDOR...									
150 A	PHASE 4 WIRE	TL4NPL6A	TL4NPL6A	TL4NPL6A	TL4NPL6A									
225 A	MOUNTING RECESSED	SCCR 65 kA	SCCR 65 kA	SCCR 65 kA	SCCR 65 kA									
	ENCLOSURE TYPE 1	CALCULATED AVAILABLE FAULT...												
REMARKS: FEED THROUGH LUGS														
LEFT SIDE, kVA			RIGHT SIDE, kVA											
DESCRIPTION	BRKR NOTES	BRKR AMP. POLES	CKT NO	A	B	C	A	B	C	CKT NO	BRKR AMP. POLES	BRKR NOTES	DESCRIPTION	
REC-4409		20 A	1	1	0.72					2			REC-4407	
REC-4409		20 A	1	3	0.72					4			REC-4407	
REC-4409		20 A	1	47	0.72					6			REC-4403,4407	
REC-4409		20 A	1	7	0.72					8				
REC-4405		20 A	1	9	0.72					10			PRINTERS-4409	
REC-4405		20 A	1	11	0.72					12			REC-4425A	
REC-4405		20 A	1	13	0.72					14			REC-4425	
REC-4405		20 A	1	15	0.72					16			REC-4423	
REC-4423A		20 A	1	17	0.72					18			REC-4419	
REC-4419A		20 A	1	19	0.72					20				
REC-4417A		20 A	1	21	0.72					22			PRINTERS-4405	
REC-4417		20 A	1	23	0.72					24			Space	
Space		20 A	1	25	--					26			Space	
Space		20 A	1	27	--					28			Space	
Space		20 A	1	29	--					30			Space	
Space		20 A	1	31	--					32			Space	
Space		20 A	1	33	--					34			Space	
Space		20 A	1	35	--					36			Space	
Space		20 A	1	37	--					38			Space	
Space		20 A	1	39	--					40			Space	
Space		20 A	1	41	--					42			Space	
1ST SECTION PHASE SUBTOTAL (kVA)			4.32 kVA			6.32 kVA			4.68 kVA					
2ND SECTION PHASE SUBTOTAL (kVA)			4.24 kVA			3.74 kVA			4.10 kVA					
ALL SECTIONS PHASE GRAND TOTAL (kVA)			8.56 kVA			10.06 kVA			8.78 kVA					
LOAD CLASSIFICATION		CONNECTED (kVA)		DEMAND FACTOR		DEMAND (kVA)								
POWER	2.00 kVA	100%	2.00 kVA		2.00 kVA									
LIGHTING	0.00 kVA		0.00 kVA		0.00 kVA									
MOTOR	0.00 kVA	125% LARGEST, 100% OTHER	0.00 kVA		0.00 kVA									
RECEPTACLE	25.40 kVA	100% FIRST 10kVA, 50% OTHER	0.00 kVA		0.00 kVA									
HEATING	0.00 kVA		0.00 kVA		0.00 kVA									
TOTAL LOAD	27.40 kVA		19.70 kVA		19.70 kVA									
TOTAL AMPS	76 A		55 A		55 A									

MAIN TYPE		VOLTAGE		LOCATION										
MCB	120/208 Wye	4TH FLOOR TOWER CORRIDOR...	4TH FLOOR TOWER CORRIDOR...	4TH FLOOR TOWER CORRIDOR...	4TH FLOOR TOWER CORRIDOR...									
150 A	PHASE 4 WIRE	TL4NPL6A	TL4NPL6A	TL4NPL6A	TL4NPL6A									
225 A	MOUNTING RECESSED	SCCR 65 kA	SCCR 65 kA	SCCR 65 kA	SCCR 65 kA									
	ENCLOSURE TYPE 1	CALCULATED AVAILABLE FAULT...												
REMARKS:														
LEFT SIDE, kVA			RIGHT SIDE, kVA											
DESCRIPTION	BRKR NOTES	BRKR AMP. POLES	CKT NO	A	B	C	A	B	C	CKT NO	BRKR AMP. POLES	BRKR NOTES	DESCRIPTION	
CSP-4403		20 A	2	43	0.50					44	2	20 A	CSP-4403	
CSP-4403		20 A	2	47	0.50					48	2	20 A	CSP-4415	
CSP-4415		20 A	2	49	0.50					50	--	--	CSP-4415	
CSP-4415		20 A	2	51	0.36					52	2	20 A	CSP-4415	
CSP-4415		20 A	2	53	0.36					54	--	--	CSP-4415	
CSP-4415		20 A	2	55	0.36					56	2	20 A	CSP-4415	
CSP-4415		20 A	2	57	0.36					58	--	--	CSP-4415	
CSP-4415		20 A	2	59	0.36					60	2	20 A	CSP-4415	
CSP-4415		20 A	2	61	0.36					62	--	--	CSP-4415	
CSP-4415		20 A	2	63	0.36					64	2	20 A	CSP-4415	
CSP-4415		20 A	2	65	0.36					66	2	20 A	CSP-4415	
CSP-4415		20 A	2	67	0.36					68	2	20 A	CSP-4415	
CSP-4415		20 A	2	69	0.36					70	2	20 A	CSP-4415	
CSP-4415		20 A	2	71	0.36					72	2	20 A	CSP-4415	
CSP-4415		20 A	2	73	0.36					74	--	--	CSP-4415	
CSP-4415		20 A	2	75	0.36					76	1	20 A	Spare	
Spare		20 A	1	79	0.00					80	1	20 A	Spare	
Spare		20 A	1	81	0.00					82	1	20 A	Spare	
Spare		20 A	1	83	0.00					84	1	20 A	Spare	
PHASE SUBTOTAL (kVA)			4.24 kVA			3.74 kVA			4.10 kVA					
PHASE SUBTOTAL (AMPS)			36 A			31 A			35 A					
LOAD CLASSIFICATION		CONNECTED (kVA)		DEMAND FACTOR		DEMAND (kVA)								
POWER	2.00 kVA	100%	2.00 kVA		2.00 kVA									
LIGHTING	0.00 kVA		0.00 kVA		0.00 kVA									
MOTOR	0.00 kVA	125% LARGEST, 100% OTHER	0.00 kVA		0.00 kVA									
RECEPTACLE	10.08 kVA	100% FIRST 10kVA, 50% OTHER	0.00 kVA		0.00 kVA									
HEATING	0.00 kVA		0.00 kVA		0.00 kVA									
TOTAL LOAD	12.08 kVA		12.04 kVA		12.04 kVA									
TOTAL AMPS	34 A		33 A		33 A									


MAIN TYPE		VOLTAGE		LOCATION									
MCB	120/208 Wye	4TH FLOOR TOWER CORRIDOR...	4TH FLOOR TOWER CORRIDOR...	4TH FLOOR TOWER CORRIDOR...	4TH FLOOR TOWER CORRIDOR...								
150 A	PHASE 4 WIRE	TL4NPL7A	TL4NPL7A	TL4NPL7A	TL4NPL7A								
225 A	MOUNTING RECESSED	SCCR 65 kA	SCCR 65 kA	SCCR 65 kA	SCCR 65 kA								
	ENCLOSURE TYPE 1	CALCULATED AVAILABLE FAULT...											
REMARKS: FEED THROUGH LUGS													
LEFT SIDE, kVA			RIGHT SIDE, kVA										
DESCRIPTION	BRKR NOTES	BRKR AMP. POLES	CKT NO	A	B	C	A	B	C	CKT NO	BRKR AMP. POLES	BRKR NOTES	DESCRIPTION
FH DDR-4415		20 A	1	1	0.18					2	1	20 A	REC-4415
FH DDR-4415		20 A	1	3	0.18					4	1	20 A	REC-4415
FH PWR-4415		20 A	1	5	1.00					6	1	20 A	REC-4415
FH PWR-4415		20 A	1	7	0.50					8	1	20 A	REC-4415
FH VP-4415		20 A	1	9	0.50					10	1	20 A	FH DDR-4415
FH DDR-4415		20 A	1	11	0.18					12	1	20 A	FH DDR-4415
FH DDR-4415													

TL4SPL1A														
MAIN TYPE MCB			VOLTAGE 120/208 Wye			LOCATION 4TH...			FED FROM TL4SPL1A			SCCR 10 kA		
MAIN RATING 250 A			PHASE 4 WIRE			MOUNTING SURFACE			ENCLOSURE TYPE 1			CALCULATED AVAILABLE FAULT...		
BUS RATING 250 A			MOUNTING SURFACE			ENCLOSURE TYPE 1			CALCULATED AVAILABLE FAULT...					
REMARKS: FEED THROUGH LUGS														
LEFT SIDE, KVA						RIGHT SIDE, KVA						DESCRIPTION		
DESCRIPTION	BRKR NOTES	BRKR AMP. POLES	CKT NO	A	B	C	A	B	C	CKT NO	BRKR AMP. POLES	BRKR NOTES	DESCRIPTION	
RECEPTACLE-4455		20 A	1	1	0.54		0.90		0.72	2	1	20 A	FH FLO-4455	
FH FLO-4455		20 A	1	3		0.72			0.72	4	1	20 A	FH FLO-4455	
FH FLO-4455		20 A	1	5		0.90			0.54	6	1	20 A	RECEPTACLE-4429	
OVEN-4455		20 A	1	7	1.20		1.20		1.20	8	1	20 A	OVEN-4455	
OVEN-4455		20 A	1	9		1.20			1.20	10	1	20 A	OVEN-4455	
FH FLO-4429		20 A	1	11		0.72			1.20	12	1	20 A	OVEN-4429	
FH FLO-4429		20 A	1	13	0.90		1.20		1.20	14	1	20 A	OVEN-4429	
OVEN-4429		20 A	1	15		1.20			0.90	16	1	20 A	FH FLO-4429	
OVEN-4429		20 A	1	17		1.20			0.72	18	1	20 A	FH FLO-4415	
FH FLO-4429		20 A	1	19	0.72		1.20		1.20	20	1	20 A	OVEN-4415	
FH FLO-4415		20 A	1	21		0.90			1.20	22	1	20 A	OVEN-4415	
OVEN-4415		20 A	1	23		1.20			0.54	24	1	20 A	GAS METERS-4443,4435,4433	
OVEN-4415		20 A	1	25	1.20		0.18		0.18	26	1	20 A	GAS METER-4451	
FH FLO-4415		20 A	1	27		0.72			1.20	28	1	20 A	FRIDGE-4451	
FH FLO-4415		20 A	1	29		0.90			1.20	30	1	20 A	FREEZER-4451	
FREEZER-4443		20 A	1	31	1.20		1.20		1.20	32	1	20 A	FRIDGE-4443	
Spare		20 A	1	33	0.00		0.00		0.00	34	1	20 A	Spare	
Spare		20 A	1	35	0.00		0.00		0.00	36	1	20 A	Spare	
Spare		20 A	1	37	0.00		0.00		0.00	38	1	20 A	Spare	
Spare		20 A	1	39	0.00		0.00		0.00	40	1	20 A	Spare	
Spare		20 A	1	41	0.00		0.00		0.00	42	1	20 A	Spare	
1ST SECTION PHASE SUBTOTAL (KVA)				11.64 kVA	9.96 kVA	9.12 kVA								
2ND SECTION PHASE SUBTOTAL (KVA)				9.66 kVA	8.16 kVA	6.48 kVA								
ALL SECTIONS PHASE GRAND TOTAL (KVA)				21.30 kVA	18.12 kVA	15.60 kVA								
LOAD CLASSIFICATION				CONNECTED (KVA)	DEMAND FACTOR	DEMAND (KVA)								
POWER				10.72 kVA	100%	10.72 kVA								
LIGHTING				0.00 kVA	100%	0.00 kVA								
MOTOR				0.00 kVA	125% LARGEST, 100% OTHER	0.00 kVA								
RECEPTACLE				44.50 kVA	100% FIRST 10kVA, 50% OTHER	27.75 kVA								
HEATING				0.00 kVA	100%	0.00 kVA								
TOTAL LOAD				55.02 kVA		37.87 kVA								
TOTAL AMPS				153 A		106 A								

TL4SPL1B														
MAIN TYPE MCB			VOLTAGE 120/208 Wye			LOCATION 4TH...			FED FROM TL4SPL1A			SCCR 10 kA		
MAIN RATING 250 A			PHASE 4 WIRE			MOUNTING SURFACE			ENCLOSURE TYPE 1			CALCULATED AVAILABLE FAULT...		
BUS RATING 250 A			MOUNTING SURFACE			ENCLOSURE TYPE 1			CALCULATED AVAILABLE FAULT...					
REMARKS:														
LEFT SIDE, KVA						RIGHT SIDE, KVA						DESCRIPTION		
DESCRIPTION	BRKR NOTES	BRKR AMP. POLES	CKT NO	A	B	C	A	B	C	CKT NO	BRKR AMP. POLES	BRKR NOTES	DESCRIPTION	
FRIDGE-4435		20 A	1	43	1.20		1.20		1.20	44	1	20 A	FREEZER-4435	
FRIDGE-4407		20 A	1	45	1.20		1.20		1.20	46	1	20 A	FRIDGE-4433	
FREEZER-4407		20 A	1	47		1.20			1.20	48	1	20 A	FREEZER-4433	
FRIDGE-4403		20 A	1	49	1.20		1.20		1.20	50	1	20 A	FREEZER-4403	
REC-4432		20 A	1	51	0.54		0.36		0.36	52	1	20 A	REC-4434	
SECURITY PANEL-4432		20 A	1	53		0.36			0.36	54	1	20 A	REC-4432	
REC-4432		20 A	1	55	0.36		0.50		0.50	56	2	20 A	POWER OUTLET-4432	
WHEELCHAIR LIFT-4400C		20 A	1	57		0.36			0.50	58	--	--	--	
BAS-4428		20 A	1	59		1.00			1.00	60	1	20 A	BAS-4428	
BAS-4428		20 A	1	61	1.00		1.00		1.00	62	1	20 A	BAS-4428	
BAS-4428		20 A	1	63	1.00		1.00		1.00	64	1	20 A	BAS-4428	
BAS-4428		20 A	1	65		1.00			0.36	66	1	20 A	GAS METERS-4403,4407	
BAS-4428		20 A	1	67	1.00		1.00		1.00	68	1	20 A	POWER DOOR-4400C	
BAS-4428		20 A	1	69		1.00			1.00	70	1	20 A	REMOTE PWR DOOR SEC 4400C	
Spare		20 A	1	71		0.00			0.00	72	1	20 A	Spare	
Spare		20 A	1	73	0.00		0.00		0.00	74	1	20 A	Spare	
Spare		20 A	1	75	0.00		0.00		0.00	76	1	20 A	Spare	
Spare		20 A	1	77	0.00		0.00		0.00	78	1	20 A	Spare	
Spare		20 A	1	79	0.00		0.00		0.00	80	1	20 A	Spare	
Spare		20 A	1	81	0.00		0.00		0.00	82	1	20 A	Spare	
Spare		20 A	1	83	0.00		0.00		0.00	84	1	20 A	Spare	
PHASE SUBTOTAL (KVA)				9.66 kVA	8.16 kVA	6.48 kVA								
PHASE SUBTOTAL (AMPS)				83 A	70 A	54 A								
LOAD CLASSIFICATION				CONNECTED (KVA)	DEMAND FACTOR	DEMAND (KVA)								
POWER				1.00 kVA	100%	1.00 kVA								
LIGHTING				0.00 kVA	100%	0.00 kVA								
MOTOR				0.00 kVA	125% LARGEST, 100% OTHER	0.00 kVA								
RECEPTACLE				23.30 kVA	100% FIRST 10kVA, 50% OTHER	16.65 kVA								
HEATING				0.00 kVA	100%	0.00 kVA								
TOTAL LOAD				24.30 kVA		17.65 kVA								
TOTAL AMPS				67 A		49 A								

TL5EPH1														
MAIN TYPE MCB			VOLTAGE 480/277 Wye			LOCATION 5TH FLOOR-TOWER-ELECTRIC...			FED FROM D5EDH1			SCCR 35 kA		
MAIN RATING 100 A			PHASE 4 WIRE			MOUNTING SURFACE			ENCLOSURE TYPE 1			CALCULATED AVAILABLE FAULT...		
BUS RATING 100 A			MOUNTING SURFACE			ENCLOSURE TYPE 1			CALCULATED AVAILABLE FAULT...					
REMARKS: PANEL IS EXISTING TO REMAIN - NEW LOADS ARE SHOWN WITH BOLD ITALIC TEXT, ALL OTHERS ARE EXISTING TO REMAIN. NEW CIRCUIT BREAKERS ARE INDICATED IN BOLD ITALIC TEXT.														
LEFT SIDE, KVA						RIGHT SIDE, KVA						DESCRIPTION		
DESCRIPTION	BRKR NOTES	BRKR AMP. POLES	CKT NO	A	B	C	A	B	C	CKT NO	BRKR AMP. POLES	BRKR NOTES	DESCRIPTION	
LTG - FOURTH FLOOR CORRIDORS		20 A	1	1	0.44		1.34		1.44	2	1	20 A	LTG - FIFTH FLOOR LABS	
LTG - FIFTH FLOOR CORRIDORS		20 A	1	3		1.68			1.44	4	1	20 A	LTG - SIXTH FLOOR CORRIDORS	
LTG - FOURTH FLOOR LABS		20 A	1	5		1.14			1.57	6	1	20 A	LTG - SIXTH FLOOR LABS	
LTG - FOURTH FLOOR CORRIDORS		20 A	1	7	0.01		--		--	8	1	--	Space	
Spare		20 A	1	9	0.00		--		--	10	1	--	Space	
Spare		20 A	1	11	0.00		--		--	12	1	--	Space	
Spare		20 A	1	13	0.00		--		--	14	1	--	Space	
Spare		20 A	1	15	0.00		--		--	16	1	--	Space	
Spare		20 A	1	17	0.00		--		--	18	1	--	Space	
Spare		20 A	1	19	0.00		--		--	20	1	--	Space	
Spare		20 A	1	21	0.00		--		--	22	1	--	Space	
Spare		20 A	1	23	0.00		--		--	24	1	--	Space	
Spare		20 A	1	25	0.00		--		--	26	1	--	Space	
Spare		20 A	1	27	0.00		--		--	28	1	--	Space	
Spare		20 A	1	29	0.00		--		--	30	1	--	Space	
Spare		20 A	1	31	0.00		--		--	32	1	--	Space	
Spare		20 A	1	33	0.00		--		--	34	1	--	Space	
Spare		20 A	1	35	0.00		--		--	36	1	--	Space	
Spare		20 A	1	37	--	--	--		--	38	1	--	Space	
Spare		20 A	1	39	--	--	--		--	40	1	--	Space	
Spare		20 A	1	41	--	--	--		--	42	1	--	Space	
PHASE SUBTOTAL (KVA)				1.78 kVA	3.12 kVA	2.69 kVA								
PHASE SUBTOTAL (AMPS)				6 A	12 A	10 A								
LOAD CLASSIFICATION				CONNECTED (KVA)	DEMAND FACTOR	DEMAND (KVA)								
POWER				0.00 kVA	100%	0.00 kVA								
LIGHTING				1.58 kVA	100%	1.58 kVA								
MOTOR				0.00 kVA	125% LARGEST, 100% OTHER	0.00 kVA								
RECEPTACLE				0.00 kVA	100% FIRST 10kVA, 50% OTHER	0.00 kVA								
HEATING				0.00 kVA	100%	0.00 kVA								
TOTAL LOAD				1.58 kVA		1.58 kVA								
TOTAL AMPS				9 A		9 A								

TL5EPL1														
MAIN TYPE MCB			VOLTAGE 120/208 Wye			LOCATION 5TH FLOOR-TOWER-ELECTRIC...			FED FROM TL5EPL1			SCCR 10 kA		
MAIN RATING 100 A			PHASE 4 WIRE			MOUNTING SURFACE			ENCLOSURE TYPE 1			CALCULATED AVAILABLE FAULT...		
BUS RATING 100 A			MOUNTING SURFACE			ENCLOSURE TYPE 1			CALCULATED AVAILABLE FAULT...					
REMARKS: PANEL IS EXISTING TO REMAIN - NEW LOADS ARE SHOWN WITH BOLD ITALIC TEXT, ALL OTHERS ARE EXISTING TO REMAIN. NEW CIRCUIT BREAKERS ARE INDICATED IN BOLD ITALIC TEXT.														
LEFT SIDE, KVA						RIGHT SIDE, KVA						DESCRIPTION		
DESCRIPTION	BRKR NOTES	BRKR AMP. POLES	CKT NO	A	B	C	A	B	C	CKT NO	BRKR AMP. POLES	BRKR NOTES	DESCRIPTION	
FA PNL 5434		20 A	1	1	1.00		1.00		1.00	2	1	20 A	FIRE ALARM POWER SUPPLY 4434	
FA PNL 6434		20 A	1	3	1.00		0.36		0.36	4	1	20 A	FIRE ALARM POWER SUPPLY 4434	
FA FAPS 4371B		20 A	1	5		1.00			0.36	6	1	20 A	FIRE ALARM POWER SUPPLY 4424	
FA AMPS 4371B		20 A	1	7	1.00		--		--	8	1	--	Space	
FA FAPS 5375A		20 A	1	9	1.00		--		--	10	1	--	Space	
FA FAPS 6375		20 A	1	11	1.00		--		--	12	1	--	Space	
FA FAPS 6375		20 A	1	13	1.00		--		--	14	1	--	Space	
FA FAPS 4434		20 A	1	15	1.00		--		--	16	1	--	Space	
LVL 5 FIRE DOOR		20 A	1	17	1.00		--		--	18				

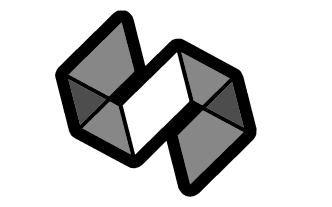

STRANG

ARCHITECTURE
ENGINEERING
INTERIOR DESIGN


811 EAST WASHINGTON
AVE
MADISON, WI 53703
T/ 608 276 9200

Consultant:



Affiliated Engineers, Inc.
5802 Research Park Boulevard
Madison, Wisconsin 53719
Tel 608.238.2616 Fax 608.238.2614

The Board of Regents of the
University of Wisconsin on behalf of
the University of Wisconsin - Madison

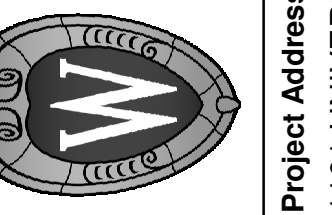

Project Address:
1101 UNIVERSITY AVENUE
MADISON, WI 53706-1322

Project Title:
CHEMISTRY 2ND AND 4TH FLOOR LAB
RENOVATION
Agency / Institution:
UNIVERSITY OF WISCONSIN-MADISON

Sheet Title:
ELECTRICAL PANEL SCHEDULE - DANIELS

Revisions

No.	Date	Description
1	9/19/2023	ADDENDUM #2

Graphic Scale

N/A

UWSA# A-22-015

Set Type BD

Date Issued 08/24/2023

Sheet Number E923-d

DL2NPL6														
MAIN TYPE		MCB		VOLTAGE		120/208 Wye		LOCATION					2ND FLOOR-TOWER MEETING...	
MAIN RATING		100 A		MOUNTING		3 PHASE 4 WIRE		FED FROM		SCCR		22 kA		
BUS RATING		100 A		ENCLOSURE		Type 1		CALCULATED AVAILABLE FAULT...		kA		kA		
REMARKS:														
LEFT SIDE, KVA						RIGHT SIDE, KVA								
DESCRIPTION	BRKR NOTES	BRKR AMP. POLES	CKT NO	A	B	C	A	B	C	CKT NO	BRKR AMP. POLES	BRKR NOTES	DESCRIPTION	
REC-2370C		20 A	1	0.72			0.72			2	1	20 A	REC-2370A	
REC-2370C		20 A	1	0.54			0.54			4	1	20 A	REC-2370	
REC-2370B		20 A	1	0.72			0.72			6	1	20 A	REC-2370	
REC-2370M		20 A	1	0.72			0.54			8	1	20 A	REC-2370L	
REC-2370M		20 A	1	0.72			0.72			10	1	20 A	REC-2370L	
REC-2370M		20 A	1	0.54			0.54			12	1	20 A	REC-2370L	
PRINTER-2370M		20 A	1	0.50			0.50			14	1	20 A	PRINTER-2370L	
REC-2370J		20 A	1	0.54			0.54			16	1	20 A	REC-2370K	
REC-2370J		20 A	1	0.72			0.72			18	1	20 A	REC-2370H	
REC-2370J		20 A	1	0.36			0.72			20	1	20 A	REC-2370G	
REC-2370F		20 A	1	0.54			0.72			22	1	20 A	REC-2370E	
REC-2370F		20 A	1	0.72			0.54			24	1	20 A	REC-2370E	
REC-2370D		20 A	1	0.72			0.50			26	1	20 A	REC-2370E	
REC-2370D		20 A	1	0.72			0.50			28	1	20 A	PRINTER-2370E	
REC-2370D		20 A	1	0.54			1.00			30	1	20 A	FRIDGE-2370N	
PRINTER-2370D		20 A	1	0.50			1.20			32	1	20 A	REC-2370N	
REC-2370N		20 A	1	1.02			0.60			34	1	20 A	REC-2370N	
MICRO-2370N		20 A	1	1.20			0.00			36	1	20 A	Spare	
FRIDGE-2370N		20 A	1	1.00			0.00			38	1	20 A	Spare	
Spare		20 A	1	0.00			0.00			40	1	20 A	Spare	
Spare		20 A	1	0.00			0.00			42	1	20 A	Spare	
Spare		20 A	1	0.00			0.00			44	1	20 A	Spare	
Spare		20 A	1	0.00			0.00			46	1	20 A	Spare	
Spare		20 A	1	0.00			0.00			48	1	20 A	Spare	
Spare		20 A	1	0.00			0.00			50	1	20 A	Spare	
Spare		20 A	1	0.00			0.00			52	1	20 A	Spare	
Spare		20 A	1	0.00			0.00			54	1	20 A	Spare	
Spare		20 A	1	0.00			0.00			56	1	20 A	Spare	
Spare		20 A	1	0.00			0.00			58	1	20 A	Spare	
Spare		20 A	1	0.00			0.00			60	1	20 A	Spare	
Spare		20 A	1	0.00			0.00			62	1	20 A	Spare	
LIGHTING-2370A,B,C,D,E,F,G,H		20 A	1	0.88			0.00			64	1	20 A	Spare	
LIGHTING-2370J,K,L,M,N		20 A	1	0.88			0.00			66	1	20 A	Spare	
PHASE SUBTOTAL (KVA)				8.92 kVA			8.76 kVA			8.84 kVA				
PHASE SUBTOTAL (AMPS)				74 A			73 A			74 A				
LOAD CLASSIFICATION	CONNECTED (KVA)	DEMAND FACTOR	DEMAND (KVA)											
POWER	0.00 kVA	100%	0.00 kVA											
LIGHTING	1.76 kVA	100%	1.76 kVA											
MOTOR	0.00 kVA	125% LARGEST, 100% OTHER	0.00 kVA											
RECEPTACLE	24.46 kVA	100% FIRST 10KVA, 50% OTHER	17.23 kVA											
HEATING	0.00 kVA	100%	0.00 kVA											
TOTAL LOAD	26.22 kVA		19.29 kVA											
TOTAL AMPS	74 A		54 A											

DL2NPL1														
MAIN TYPE		MCB		VOLTAGE		120/208 Wye		LOCATION					2ND FLOOR-TOWER...	
MAIN RATING		150 A		MOUNTING		3 PHASE 4 WIRE		FED FROM		SCCR		22 kA		
BUS RATING		100 A		ENCLOSURE		Type 1		CALCULATED AVAILABLE FAULT...		kA		kA		
REMARKS: PANEL IS EXISTING TO REMAIN - NEW LOADS ARE SHOWN WITH BOLD ITALIC TEXT, ALL OTHERS ARE EXISTING TO REMAIN. NEW CIRCUIT BREAKERS ARE INDICATED IN BOLD ITALIC TEXT.														
LEFT SIDE, KVA						RIGHT SIDE, KVA								
DESCRIPTION	BRKR NOTES	BRKR AMP. POLES	CKT NO	A	B	C	A	B	C	CKT NO	BRKR AMP. POLES	BRKR NOTES	DESCRIPTION	
REC-2364-2360		20 A	1	0.72			0.54			2	1	20 A	REC-2300S-2300V	
REC-2300T		20 A	1	0.72			0.54			4	1	20 A	REC-2300T	
LTG-2300S		20 A	1	0.56			0.60			6	1	20 A	LTG-2300T	
LTG-2360-2364		20 A	1	0.15			0.54			8	1	20 A	REC-2300T	
HAND DRYER-2360		20 A	1	1.00			0.00			10	1	20 A	Spare	
HAND DRYER-2360		20 A	1	1.00			0.00			12	1	20 A	Spare	
Spare		20 A	1	0.00			0.00			14	1	20 A	Spare	
Spare		20 A	1	0.00			0.00			16	1	20 A	Spare	
Spare		20 A	1	0.00			0.00			18	1	20 A	Spare	
Spare		20 A	1	0.00			0.00			20	1	20 A	Spare	
LTG-2344		20 A	1	1.00			0.72			22	1	20 A	REC-2344	
LTG-2344		20 A	1	1.00			0.72			24	1	20 A	REC-2344	
LTG-2344		20 A	1	1.00			0.72			26	1	20 A	CLNG REC-2344	
STAIRWELL PLUG		20 A	2	0.50			0.72			28	1	20 A	REC-HALLWAY	
--		--	--	29			0.50			30				
				31						32				
				33						34				
				35						36				
				37						38				
				39						40				
				41						42				
				43						44				
				45						46				
				47						48				
				49						50				
				51						52				
				53						54				
				55						56				
				57						58				
				59						60				
				61						62				
				63						64				
				65						66				
PHASE SUBTOTAL (KVA)				3.67 kVA			5.20 kVA			4.38 kVA				
PHASE SUBTOTAL (AMPS)				31 A			44 A			37 A				
LOAD CLASSIFICATION	CONNECTED (KVA)	DEMAND FACTOR	DEMAND (KVA)											
POWER	3.00 kVA	100%	3.00 kVA											
LIGHTING	4.31 kVA	100%	4.31 kVA											
MOTOR	0.00 kVA	125% LARGEST, 100% OTHER	0.00 kVA											
RECEPTACLE	5.94 kVA	100% FIRST 10KVA, 50% OTHER	5.94 kVA											
HEATING	0.00 kVA	100%	0.00 kVA											
TOTAL LOAD	13.25 kVA		13.25 kVA											
TOTAL AMPS	37 A		37 A											